

STATE OF KANSAS
STATE CORPORATION COMMISSION

Form CP-4


Give All Information Completely
Make Required Affidavit
Mail or Deliver Report to:
Conservation Division
State Corporation Commission
212 No. Market
Wichita, Kansas 67202

WELL PLUGGING RECORD

Hodgeman County, Sec. 26 Twp. 22 Rge. (E) 22 (W)

Location as "NE/CNW/SW" or footage from lines SW NW NE
Lease Owner Cities Service Oil Company
Lease Name Hann "A" Well No. 1
Office Address Box 308, Great Bend, Kansas
Character of Well (completed as Oil, Gas or Dry Hole) oil
Date well completed 19
Application for plugging filed March 12 1970
Application for plugging approved 19
Plugging commenced June 25 1970
Plugging completed July 3 1970
Reason for abandonment of well or producing formation depleted

If a producing well is abandoned, date of last production 19
Was permission obtained from the Conservation Division or its agents before plugging was commenced? yes

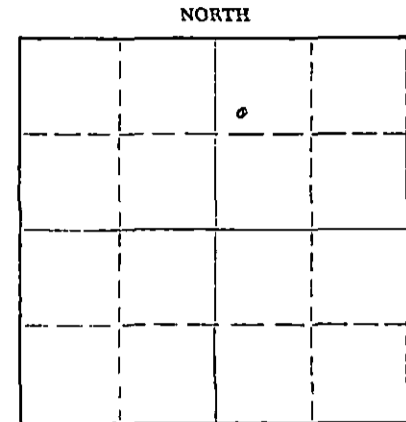

Locate well correctly on above Section Flat

Name of Conservation Agent who supervised plugging of this well Edgar Eves
Producing formation Depth to top Bottom Total Depth of Well 4409 Feet
Show depth and thickness of all water, oil and gas formations.

OIL, GAS OR WATER RECORDS

CASING RECORD

FORMATION	CONTENT	FROM	TO	SIZE	PUT IN	PULLED OUT
		0	249'	8 5/8"	249'	none
		0	4393'	5 1/8"	4393'	3182'

Describe in detail the manner in which the well was plugged, indicating where the mud fluid was placed and the method or methods used in introducing it into the hole. If cement or other plugs were used, state the character of same and depth placed, from feet to feet for each plug set.

Sanded back to 4400' and dumped 5 sacks of cement.

Pumped 5 sacks of gel mud, 80 sacks of cement, 4 sacks of mud, 30 sacks of cement 4 sacks of mud and 10 sacks of cement.

RECEIVED
STATE CORPORATION COMMISSION
JUL 10 1970
CONSERVATION DIVISION
Wichita, Kansas

(If additional description is necessary, use BACK of this sheet)
Name of Plugging Contractor PIPE PULLERS, INC.
Address Box 486, Ellinwood, Kansas

STATE OF Kansas, COUNTY OF Barton, ss.
Evelyn Roth (employee of owner) or (owner or operator) of the above-described well, being first duly sworn on oath, says: That I have knowledge of the facts, statements, and matters herein contained and the log of the above-described well as filed and that the same are true and correct. So help me God.

(Signature) Evelyn Roth
Ellinwood, Kansas (Address)

SUBSCRIBED AND SWORN TO before me this 9th day of July, 1970

Commission expires Feb. 10, 1971

Serge A Meyer (Notary Public)

WELL LOG BUREAU--KANSAS GEOLOGICAL SOCIETY
508 East Murdock, Wichita, Kansas

15. 093-10092-0000


COPY

Company- IMPERIAL OIL CO.
Farm- Hann "A" No. 1

SEC. 26 T. 22 R. 22W
SW NW NE

Total Depth. 4409'
Comm. 11-29-62 Comp. 12-13-62
Shot or Treated.
Contractor.
Issued. 9-7-63

County Hodgeman
KANSAS

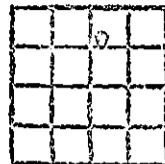

CASING:
8 5/8" 2493' cem w/200 sx.
5 1/2" 4393' cem w/150 sx.

Elevation. 2164' KB

Production. 112 BOPD, NW

Figures Indicate Bottom of Formations.

sand & shale	655
Falso Anhydrite	675
shale & sand	1297
Anhydrite	1326
shale & shells	2100
shale & lime	3780
lime	4386
lime & chert	4396
chert	4400
lime & chert	4409 RTD.
Total Depth	

TOPS: LCG.	
Heebner.	3719
Lansing	3799
Base Kansas City	4117
Marmaton	
Cherokee Shale	4298
Conglomerate Shale	4366
Mississippi Osage	4388

RECEIVED
STATE CORPORATION COMMISSION
MAR 13 1970
CONSERVATION DIVISION
Wichita, Kansas