


STATE OF KANSAS  
STATE CORPORATION COMMISSION

WELL PLUGGING RECORD

Give All Information Completely  
Make Required Affidavit  
Mail or Deliver Report to:  
Conservation Division  
State Corporation Commission  
212 No. Market  
Wichita, Kansas

Hodgeman County, Sec. 26 Twp. 22S Rge. (E) 22 (W)  
Location as "NE/CNW4SW4" or footage from lines  
Lease Owner Cities Service Oil Company  
Lease Name Hann "D" Well No. 1  
Office Address Box 308, Great Bend, Kansas  
Character of Well (completed as Oil, Gas or Dry Hole) oil  
Date well completed 19  
Application for plugging filed July 8 19 69  
Application for plugging approved 19  
Plugging commenced July 14 19 69  
Plugging completed July 22 19 69  
Reason for abandonment of well or producing formation depleted

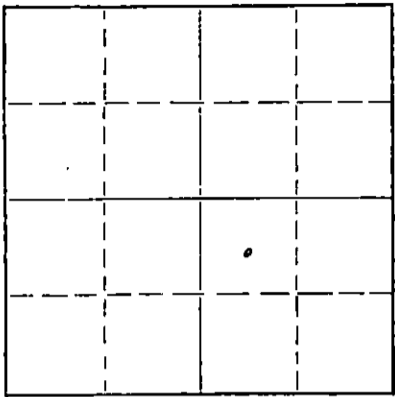

Locate well correctly on above  
Section Plat

If a producing well is abandoned, date of last production 19  
Was permission obtained from the Conservation Division or its agents before plugging was commenced? yes

Name of Conservation Agent who supervised plugging of this well Edgar J. Eves  
Producing formation Depth to top Bottom Total Depth of Well 4421 Feet  
Show depth and thickness of all water, oil and gas formations.

OIL, GAS OR WATER RECORDS

CASING RECORD

FORMATION	CONTENT	FROM	TO	SIZE	PUT IN	PULLED OUT
				8 5/8"	275'	none
				5 1/2"	4417'	3296.77

Describe in detail the manner in which the well was plugged, indicating where the mud fluid was placed and the method or methods used in introducing it into the hole. If cement or other plugs were used, state the character of same and depth placed, from feet to feet for each plug set.

Plugged back to 4400' with 10' of sand and 5 sacks of cement.

Squeezed well with 120 sacks of cement and 15 sacks of gel mud.

RECEIVED  
STATE CORPORATION COMMISSION  
AUG 6 1969  
CONSERVATION DIVISION  
Wichita, Kansas  
8-6-69

Name of Plugging Contractor PIPE PULLERS, INC.  
Address Box 486, Ellinwood, Kansas

STATE OF Kansas, COUNTY OF Barton, ss.  
Evelyn Roth (employee of owner) or (owner or operator) of the above-described well, being first duly sworn on oath, says: That I have knowledge of the facts, statements, and matters herein contained and the log of the above-described well as filed and that the same are true and correct. So help me God.

(Signature) Evelyn Roth  
Ellinwood, Kansas (Address)

SUBSCRIBED AND SWORN TO before me this 24th day of July, 19 69

My commission expires Feb. 10, 1971

George H. Meyer  
Notary Public

DRILLER'S LOG

Imperial Oil Company.  
780 Fourth National Building  
Wichita, Kansas

RECEIVED  
STATE CORPORATION COMMISSION  
JUL 9 1969  
CONSERVATION DIVISION  
Wichita, Kansas

HANN "D" NO. 1  
C NW SE Sec. 26-22S-22W  
Hodgeman County, Kansas

Total Depth: 4421'

Elevation: 2167 K.B.

Commenced: 5/7/63 Completed: 5/17/63

Contractor: Imperial Oil of Kansas, Inc.  
Wichita 2, Kansas

Casing Record: Set 8-5/8" surface pipe at 275' with 200 sacks cement.  
Set 5-1/2" production pipe at 4417' with 150 sacks #1 Posmix.

Figures indicate bottom of formations:

Tops

Sand & Shale	650'	Anhydrite	1297 (+870)
Anhydrite	662'	Heebner	3730 (-1563)
Shale & Sand	1297'	Toronto	3748 (-1581)
Anhydrite	1335'	Douglas Lime	3792 (-1625)
Shale & Lime	3840'	Lansing	3814 (-1647)
Lime	4416'	B/Kansas city	4135 (-1968)
Chert	4421'	Cherokee Shale	4323 (-2156)
		Conglomerate	4392 (-2225)
		Osage	4416 (-2249)
		RTD	4421 (-2254)

We hereby certify this to be a correct and accurate log of the above described well, as shown on the daily drilling reports.

IMPERIAL OIL COMPANY

By Raymond R. Dombaugh  
Raymond R. Dombaugh

Subscribed and sworn to before me this 21st day of May, 1963.

My Commission Expires:

July 5, 1965

Bette J. Silcott  
Bette J. Silcott, Notary Public