

STATE OF KANSAS  
STATE CORPORATION COMMISSION

Form CP-4


Give All Information Completely  
Make Required Affidavit  
Mail or Deliver Report to:  
Conservation Division  
State Corporation Commission  
212 No. Market  
Wichita, Kansas 67202

WELL PLUGGING RECORD

Hodgeman County, Sec. 26 Twp. 22 Rge. (E) 22 (W)

Location as "NE/CNW/SW" or footage from lines C NE SW  
Lease Owner Cities Service Oil Company  
Lease Name Hertel Well No. 1  
Office Address Box 308, Great Bend, Kansas  
Character of Well (completed as Oil, Gas or Dry Hole) oil  
Date well completed \_\_\_\_\_ 19\_\_\_\_  
Application for plugging filed March 12 1970  
Application for plugging approved \_\_\_\_\_ 19\_\_\_\_  
Plugging commenced June 5 1970  
Plugging completed July 3 1970  
Reason for abandonment of well or producing formation depleted

If a producing well is abandoned, date of last production \_\_\_\_\_ 19\_\_\_\_  
Was permission obtained from the Conservation Division or its agents before plugging was commenced? yes

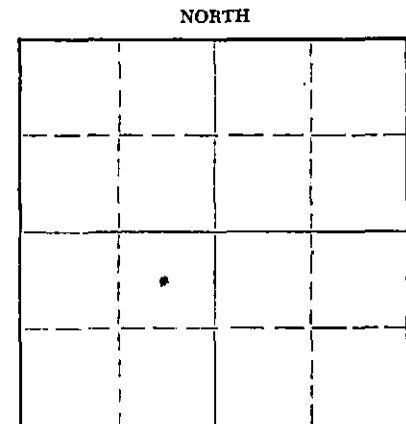

Locate well correctly on above Section Plat

Name of Conservation Agent who supervised plugging of this well Edgar Eves  
Producing formation \_\_\_\_\_ Depth to top \_\_\_\_\_ Bottom \_\_\_\_\_ Total Depth of Well 4417 Feet  
Show depth and thickness of all water, oil and gas formations.

OIL, GAS OR WATER RECORDS

CASING RECORD

FORMATION	CONTENT	FROM	TO	SIZE	PUT IN	PULLED OUT
		0	347'	8 5/8"	347'	none
		0	4409'	5 1/2"	4409'	1367'

Describe in detail the manner in which the well was plugged, indicating where the mud fluid was placed and the method or methods used in introducing it into the hole. If cement or other plugs were used, state the character of same and depth placed, from \_\_\_\_\_ feet to \_\_\_\_\_ feet for each plug set.

Sanded back to 1400' and dumped 5 sacks of cement.

Pumped 5 sacks of mud, 80 sacks of cement, 4 sacks of mud, 30 sacks of cement, 4 sacks of mud and 10 sacks of cement to plug well.

RECEIVED  
STATE CORPORATION COMMISSION  
JUL 17 1970  
CONSERVATION DIVISION  
Wichita, Kansas  
7-17-70

(If additional description is necessary, use BACK of this sheet)  
Name of Plugging Contractor PIPE PULLERS, INC.  
Address Box 486, Ellinwood, Kansas

STATE OF KANSAS, COUNTY OF BARTON, ss.  
Evelyn Roth (employee of owner) or (owner or operator) of the above-described well, being first duly sworn on oath, says: That I have knowledge of the facts, statements, and matters herein contained and the log of the above-described well as filed and that the same are true and correct. So help me God.

(Signature) Evelyn Roth  
Ellinwood, Kansas  
(Address)

SUBSCRIBED AND SWORN to before me this 16th day of July 1970

My commission expires Feb. 10, 1971

George Meyer  
Notary Public.

STENCILED

5.083-10108-0000

SEP 7 1963

DRILLER'S LOG RECEIVED  
STATE CORPORATION COMMISSION

ORIGINAL

Imperial Oil Company  
780 Fourth National Building  
Wichita, Kansas

MAR 13 1970  
CONSERVATION DIVISION  
Wichita, Kansas

HERTEL NO. 1  
C NE SW 26-22S-22W  
Hodgeman County, Kansas

Total Depth: 4417

Elevation 2164 K.B.

Commenced: 3/1/63 Completed 3/11/63

Contractor: Imperial Oil of Kansas, Inc.  
Wichita 2, Kansas

*Op: 79 Boyd, the water.*

Casing Record: Set 8-5/8" surface pipe at 347' with 250 sacks cement.  
Set 5-1/2" production pipe at 4409' with 150 sacks Pozmix.

Figures indicate bottom of formations:

Tops

Sand & Shale	446'	Anhydrite	1291 (-7873)
Shale	460'	Heebner	3723 (-1559)
Shale & Sand	654'	Toronto	3744 (-1580)
False Anhydrite	663'	Douglas Lime	3786 (-1622)
Dakota Sand	925'	Lansing	3806 (-1642)
Anhydrite	1334'	B/Kansas City	4131 (-1967)
		Cherokee Shale	4317 (-2153)
Sand & Shale	1935'	Conglomerate	4384 (-2220)
Lime & Shale	3805'	Osage	4406 (-2242)
Lime	4405'	R.T.D.	4417 (-2253)
Lime & Chert	4417' <i>RTD</i>		

We hereby certify this to be a correct and accurate log of the above described well, as shown on the daily drilling reports.

IMPERIAL OIL COMPANY

*Raymond R. Dombaugh*  
Raymond R. Dombaugh

Subscribed and sworn to before me this 20th day of March, 1963.

My Commission Expires:

July 5, 1966

*Bette J. Silcott*  
Bette J. Silcott, Notary Public