


WELL PLUGGING RECORD

Give All Information Completely
Make Required Affidavit
Mail or Deliver Report to
Conservation Division
State Corporation Commission
211 No. Broadway
Wichita, Kansas

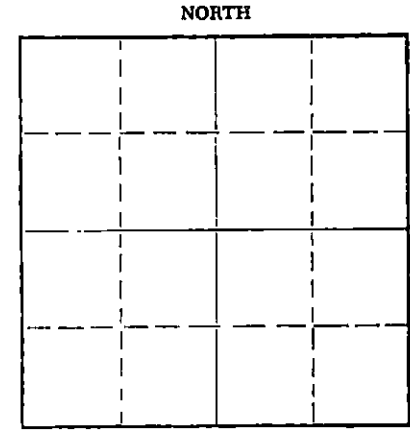

Locate well correctly on above
Section Plat

Pawnee County. Sec. 4 Twp. 22 Rge. (E) 16 (W)
Location as "NE/CNW/SW" or footage from lines. SE SW NW
Lease Owner Toland & Reeves
Lease Name Dodge Matney Unit Well No. 2
Office Address Box 4336, Okla City 9, Okla.
Character of Well (completed as Oil, Gas or Dry Hole) oil
Date well completed _____ 19____
Application for plugging filed 11-30- 1961
Application for plugging approved _____ 19____
Plugging commenced 1-2 1962
Plugging completed 1-4 1962
Reason for abandonment of well or producing formation _____

If a producing well is abandoned, date of last production _____ 19____
Was permission obtained from the Conservation Division or its agents before plugging was commenced? yes

Name of Conservation Agent who supervised plugging of this well W. L. Laekamp
Producing formation _____ Depth to top _____ Bottom _____ Total Depth of Well 3900' Feet
Show depth and thickness of all water, oil and gas formations.

OIL, GAS OR WATER RECORDS CASING RECORD

FORMATION	CONTENT	FROM	TO	SIZE	PUT IN	PULLED OUT
				8 5/8"	993	none
				5 1/2"	3900	2820'

Describe in detail the manner in which the well was plugged, indicating where the mud fluid was placed and the method or methods used in introducing it into the hole. If cement or other plugs were used, state the character of same and depth placed, from _____ feet to _____ feet for each plug set.

Top Perforation 3839'

Sanded hole from 3900' to 3820'-
dumped 5 sks cement-pulled casing-
mudded hole to 310'-set 10' rock
bridge-dumped 20 sks cement-mudded
hole to 40'-set 10' rock bridge-
dumped 10 sks cement.

RECEIVED
STATE CORPORATION COMMISSION
FEB 8 1962
CONSERVATION DIVISION
Wichita, Kansas

2-8-62

(If additional description is necessary, use BACK of this sheet)
Name of Plugging Contractor R & D Casing Pulling Co. License 236
Address Box 572, Hutchinson, Kansas

STATE OF Oklahoma, COUNTY OF Oklahoma, ss.

(employee of owner) or (owner or operator) of the above-described well, being first duly sworn on oath, says: That I have knowledge of the facts, statements, and matters herein contained and the log of the above-described well as filed and that the same are true and correct. So help me God.
(Signature) Daggett Toland

SUBSCRIBED AND SWORN to before me this 1st day of February, 1962
(Address) _____
Lois Wilsey
Notary Public.

My commission expires October 21, 1963



CONTRACTOR'S WELL LOG

COMPANY:	A. F. Bram
CONTRACTOR:	Musgrove Petroleum Corporation
FARM:	DODGE MATNEY #2
LOCATION:	SE SW NW, Sec. 4-22-16W Pawnee County, Kansas
COMMENCED:	June 9, 1956
COMPLETED:	June 21, 1956

0	60	Sand
60	213	Shale
213	430	Shale & shells
430	525	Sand
525	892	Shale & shells
892	992	Anhydrite
992	1570	Anhydrite, shale & shells
1570	1830	Shale & lime streaks
1830	2530	Shale & lime
2530	2845	Shale & lime streaks
2845	3760	Lime & shale
3760	3815	Lime
3815	3857	Lime & shale
3857	3900	Lime
	3900	Rotary Total Depth

RECEIVED
STATE CORPORATIONS COMMISSION
DEC 1 1956
CONSERVATION DIVISION
Wichita, Kansas

Set 8-5/8" surface casing at 993' with 500 sacks cement.

Set 5-1/2" casing at 3900' with 150 sacks Posnix.

STATE OF KANSAS }
COUNTY OF SEDGWICK } SS

I, GORDON L. KOELLING, do hereby certify that the above and foregoing is a true and correct copy of the log of the DODGE MATNEY #2, SE SW NW of Section 4-22-16, Pawnee County, Kansas, as reflected by the files of the Musgrove Petroleum Corporation.

MUSGROVE PETROLEUM CORPORATION

BY Gordon L. Koelling
Secretary-Treasurer

Subscribed and sworn to before me, a Notary Public, in and for Sedgwick County, Kansas, this 25th day of June, 1956.

Leah Jane Helce
Notary Public

My commission expires June 16, 1959.