


WELL PLUGGING RECORD

Give All Information Completely  
Make Required Affidavit  
Mail or Deliver Report to:  
Conservation Division  
State Corporation Commission  
211 No. Broadway  
Wichita, Kansas

NORTH

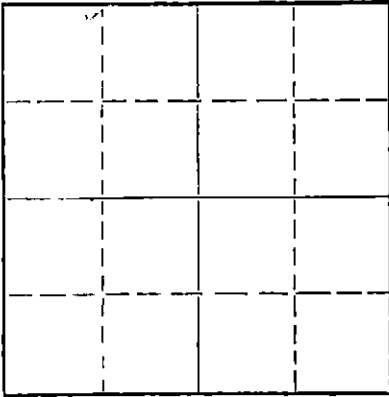

Locate well correctly on above Section Plat

Pawnee County, Sec. 4 Twp. 22 Rge. (E) 16 (W)  
Location as "NE/CNW/SW" or footage from lines 330' south of North line-330'  
west of East Line NE 10 acres  
Lease Owner. Toband & Reeves  
Lease Name Dodge-Matneu Unit Well No. 1  
Office Address Box 4336, Okla City 9, Okla.  
Character of Well (completed as Oil, Gas or Dry Hole) Oil  
Date well completed \_\_\_\_\_ 19\_\_\_\_  
Application for plugging filed 11-30 1961  
Application for plugging approved \_\_\_\_\_ 19\_\_\_\_  
Plugging commenced 12-23 1961  
Plugging completed 12-28 1961  
Reason for abandonment of well or producing formation \_\_\_\_\_

If a producing well is abandoned, date of last production \_\_\_\_\_ 19\_\_\_\_  
Was permission obtained from the Conservation Division or its agents before plugging was commenced? yes

Name of Conservation Agent who supervised plugging of this well W. L. Lackamp  
Producing formation \_\_\_\_\_ Depth to top \_\_\_\_\_ Bottom \_\_\_\_\_ Total Depth of Well 3892' Feet  
Show depth and thickness of all water, oil and gas formations.

OIL, GAS OR WATER RECORDS

CASING RECORD

FORMATION	CONTENT	FROM	TO	SIZE	PUT IN	PULLED OUT
				8 5/8"	980'	none
				5 1/2"	3893'	1775'

Describe in detail the manner in which the well was plugged, indicating where the mud fluid was placed and the method or methods used in introducing it into the hole. If cement or other plugs were used, state the character of same and depth placed, from \_\_\_\_\_ feet to \_\_\_\_\_ feet for each plug set.

Top Perforation 3839'

Sanded hole from 3892' to 3820'-  
dumped 5 sks cement-pulled casing-  
bailed oil out of hole-mudded hole  
to 310'-set 10' rock bridge-dumped  
20 sks cement-mudded hole to 40'-  
set 10' rock bridge-dumped 10 sks  
cement

RECEIVED  
STATE CORPORATION COMMISSION

FEB 2 1962

CONSERVATION DIVISION  
Wichita, Kansas

2-2-62

(If additional description is necessary, use BACK of this sheet)  
Name of Plugging Contractor R & D Casing Plugging Co. License #236  
Address Box 572, Hutchinson, Kansas

STATE OF Oklahoma, COUNTY OF Oklahoma, ss. \_\_\_\_\_  
(employee of owner) or (owner or operator) of the above-described well, being first duly sworn on oath, says: That I have knowledge of the facts, statements, and matters herein contained and the log of the above-described well as filed and that the same are true and correct. So help me God.

(Signature) Douglas E. Toland  
P. O. Box 4336, Okla. City 9, Okla.  
(Address)

SUBSCRIBED AND SWORN to before me this 1st day of February, 1962

My commission expires October 21, 1963

Lois Kelley  
Notary Public.



CONTRACTOR'S WELL LOG

COMPANY:	A. F. Brann
CONTRACTOR:	Musgrove Petroleum Corporation
FARM:	DODGE-MATNEY UNIT #1
LOCATION:	330' South of North Line, 330' West of East Line NE 10 acres of Sec. 4-22-16 Pawnee County, Kans.
COMMENCED:	April 1, 1956
COMPLETED:	April 11, 1956

0	160	Sand
160	412	Shale
412	520	Sand
520	660	Shells, shale & sand
660	727	Shale
727	845	Shale & red bed
845	977	Shale & shells
977	1005	Anhydrite
1005	1735	Shells & shale
1735	1764	Shale
1764	1931	Line
1931	3625	Line & shale
3625	3700	Line
3700	3830	Line & shale
3830	3890	Line
	3890	Rotary Total Depth

STAMP: CONSERVATION DIVISION, Sedgwick, Kansas

Set 8-5/8" surface casing at 981' w/500 sx 1 conmix.

Set 5-1/2" casing at 3892' w/130 sx cement.

STATE OF KANSAS }  
COUNTY OF SEDGWICK } SS

I, GORDON L. KOELLING, do hereby certify that the above and foregoing is a true and correct copy of the log of the DODGE MATNEY UNIT #1, located in the NE 10 acres of Section 4-22-16, Pawnee County, Kansas, as reflected by the files of the Musgrove Petroleum Corporation.

MUSGROVE PETROLEUM CORPORATION

*Gordon L. Koelling*  
Secretary-Treasurer

Subscribed and sworn to before me, a Notary Public, in and for Sedgwick County, Kansas, this 16th day of April, 1956.

*Leah Joyce Wefke*  
Notary Public

My commission expires June 16, 1959.