


STATE OF KANSAS
STATE CORPORATION COMMISSION

Give All Information Completely
Make Required Affidavit
Mail or Deliver Report to:
Conservation Division
State Corporation Commission
211 No. Broadway
Wichita, Kansas

WELL PLUGGING RECORD

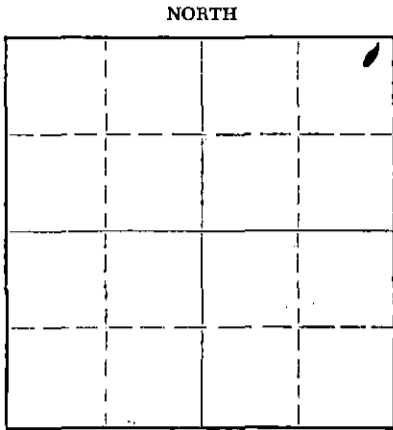

Locate well correctly on above Section Plat

Pawnee County. Sec. 4 Twp. 22S Rge. xxx 16(W)
Location as "NE/CNW/SW" or footage from lines. NE NE NE
Lease Owner Gulf Oil Corporation
Lease Name O. M. Hanshew Well No. 1
Office Address Box 661, Tulsa Oklahoma
Character of Well (completed as Oil, Gas or Dry Hole) Oil
Date well completed 10-14 19 53
Application for plugging filed 12-18 19 57
Application for plugging approved 12-20 19 57
Plugging commenced 12-26 19 57
Plugging completed 1-3 19 58
Reason for abandonment of well or producing formation Well operating below its economic limit.
If a producing well is abandoned, date of last production 10-31 1957
Was permission obtained from the Conservation Division or its agents before plugging was commenced? Yes

Name of Conservation Agent who supervised plugging of this well J. Lewis Brock
Producing formation Arbuckle Depth to top 3856' Bottom 3863' Total Depth of Well 3863' Feet
Show depth and thickness of all water, oil and gas formations.

OIL, GAS OR WATER RECORDS

CASING RECORD

FORMATION	CONTENT	FRDM	TD	SIZE	PUT IN	PULLED OUT
				13"	115'	- 0 -
				8-5/8"	988'	- 0 -
				5-1/2"	3857'	1,953'

Describe in detail the manner in which the well was plugged, indicating where the mud fluid was placed and the method or methods used in introducing it into the hole. If cement or other plugs were used, state the character of same and depth placed, from _____ feet to _____ feet for each plug set.

Filled with sand to 3,800' and spotted 5 sx. cement. Filled with mud to 900'. Placed rock bridge and spotted 20 sx. cement to 840'. Mudded to 300'. Placed rock bridge and spotted 20 sx. cement to 240'. Mudded to 30'. Placed rock bridge and capped with 10 sx. cement filling hole into cellar.

1-10-58

W. C. Bunch - Special Petty Cash, Check No. 2012, dated 1-9-58, in the amount of \$38.63 is attached as payment of plugging assessment.

RECEIVED
STATE CORPORATION COMMISSION

JAN 10 1958

CONSERVATION DIVISION
Wichita, Kansas

(If additional description is necessary, use BACK of this sheet)
Name of Plugging Contractor C. E. Shull Casing Pulling Company
Address Great Bend, Kansas

STATE OF Kansas, COUNTY OF Sedgwick, ss.
Thomas A. Trax (employee of owner) ~~(owner or operator)~~

well, being first duly sworn on oath, says: That I have knowledge of the facts, statements, and matters herein contained and the log of the above-described well as filed and that the same are true and correct. So help me God.

(Signature) [Signature]
Box 2233, Wichita, Kansas
(Address)

SUBSCRIBED AND SWORN TO before me this 9th day of January, 19 58

My commission expires 6-3-61

C. C. LEWIS, NOTARY PUBLIC Notary Public.

PLUGGING
FILE SEC 4 T 22R 164
BOOK PAGE 70 LINE 44

O. M. HANSHEW NO. 1
 CENTER NE NE SEC. 4-22S-16W
 PAWNEE COUNTY, KANSAS
 GULF OIL CORPORATION

13-3/8" O. D. casing cemented at 115'
 8-5/8" O. D. casing cemented at 988'
 5-1/2" O. D. casing cemented at 3858'

Drilling commenced September 24, 1953
 Drilling completed October 6, 1953

FROM	TO	FORMATION	REMARKS
0'	115'	Surface	
115	230	Sand & shale	13-3/8" O. D. casing cemented with 140 sacks cement at 115'
230	425	Shale	
425	550	Sand	
550	610	Shale & shells	
610	925	Red bed & shale	
925	983	Red bed	
983	1010	Anhydrite	8-5/8" O. D. casing cemented with 425 sacks cement at 988'
1010	1090	Shale	
1090	1595	Shale & shells	
1595	1920	Shale & lime	
1920	2130	Lime & shale	
2130	2215	Lime	
2215	2325	Shale & lime	
2325	2765	Lime & shale	
2765	2935	Shale & lime	
2935	3050	Lime & shale	
3050	3110	Lime	
3110	3280	Lime & shale	
3280	3380	Lime	
3380	3430	Shale & lime	
3430	3480	Sand	
3480	3540	Lime & shale	
3540	3750	Lime	
3750	3795	Lime & shale	
3795	3858	Lime	5-1/2" O. D. casing cemented with 100 sacks cement at 3858'

T.D. 3858'

Drilled deeper to 3863'

RECEIVED
 STATE CORPORATION COMMISSION

DEC 20 1957

PLUGGING
 FILE - SEC. 4 T. 22 R. 16W
 BOOK PAGE 70 LINE 44