


STATE OF KANSAS  
STATE CORPORATION COMMISSION

WELL PLUGGING RECORD

Give All Information Completely  
Make Required Affidavit  
Mail or Deliver Report to:  
Conservation Division  
State Corporation Commission  
800 Bittig Building  
Wichita, Kansas

Pawnee County. Sec. 4 Twp. 22 Rge. 16 (W)  
Location as "NE/CNW/SW" or footage from lines C S/2 NW SE  
Lease Owner Rocket Drilling Company, Inc.  
Lease Name Nauert-Simmons Well No. 1  
Office Address 352 North Broadway, Wichita 2, Kansas  
Character of Well (completed as Oil, Gas or Dry Hole) Dry Hole  
Date well completed October 29, 19 57  
Application for plugging filed October 29, 19 57  
Application for plugging approved October 30, 19 57  
Plugging commenced October 29, 19 57  
Plugging completed October 29, 19 57  
Reason for abandonment of well or producing formation Non-commercial

NORTH

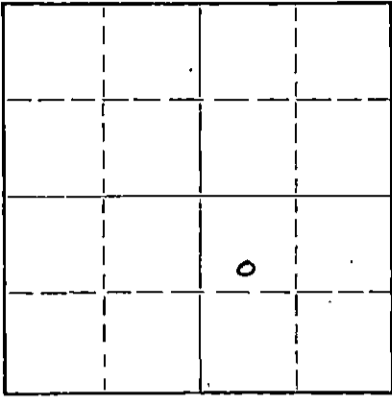

Locate well correctly on above  
Section Plat

If a producing well is abandoned, date of last production \_\_\_\_\_ 19 \_\_\_\_  
Was permission obtained from the Conservation Division or its agents before plugging was commenced? Yes

Name of Conservation Agent who supervised plugging of this well Don Truan, Rt. 1 Russell, Kansas  
Producing formation \_\_\_\_\_ Depth to top \_\_\_\_\_ Bottom \_\_\_\_\_ Total Depth of Well 3870 Feet  
Show depth and thickness of all water, oil and gas formations.

OIL, GAS OR WATER RECORDS

CASING RECORD

FORMATION	CONTENT	FROM	TO	SIZE	PUT IN	PULLED OUT
				8 5/8"	990'	-0-

Describe in detail the manner in which the well was plugged, indicating where the mud fluid was placed and the method or methods used in introducing it into the hole. If cement or other plugs were used, state the character of same and depth placed, from \_\_\_\_\_ feet to \_\_\_\_\_ feet for each plug set.

Filled hole with heavy mud to 990 feet. Set wooden plug and dumped 30 sacks of cement.  
Filled with heavy mud to 350 feet, set wooden plug and dumped 20 sacks of cement. Filled with heavy mud to 40 feet, set wooden plug and dumped 10 sacks of cement to base of cellar.

NO. 5 11-5-57

CONSERVATION DIVISION  
Wichita, Kansas

(If additional description is necessary, use BACK of this sheet)

Name of Plugging Contractor Rocket Drilling Company, Inc.  
Address 352 North Broadway, Wichita, Kansas


STATE OF Kansas, COUNTY OF Sedgwick, ss.  
R. J. Harwood (employee of owner) or (owner or operator) of the above-described well, being first duly sworn on oath, says: That I have knowledge of the facts, statements, and matters herein contained and the log of the above-described well as filed and that the same are true and correct. So help me God.

(Signature) R. J. Harwood  
R. J. Harwood  
352 North Broadway, Wichita 2, Kans. (Address)

SUBSCRIBED AND SWORN to before me this 31st day of October, 19 57

M. S. Davis  
M. S. Davis Notary Public.

My commission expires 1-23-60

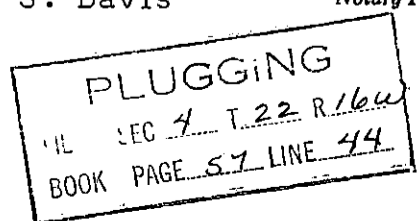

DRILLERS LOG

Operator---- Rocket Drilling Company, Wichita, Kansas.  
 Lease-- Nauert-Simmons No. 1  
 Location---- Center S/2 NW SE of Section 4-22S-16W.  
 Contractor-- Adkins Drilling Company, Inc. Great Bend, Kansas.

Formation	From	To
Sand	0	70
Sand Stone	70	120
Shale & Red Bed	120	437
Dakota	437	519
Shale	519	722
Shale & Shells	722	980
Anhydrite	980	990
Set 990 ft. of 8 5/8" surface casing and cemented same with 450 sacks of cement. Cement circulated.		
Cement and Plug	960	990
Anhydrite	990	1005
Shale & Shells	1005	1734
Lime	1734	1768
Lime & Shale	1768	1880
Lime	1880	2280
Lime & Shale	2280	2395
Shale	2395	2525
Shale & Lime	2525	3135
Lime	3135	3270
Lime & Shale	3270	3347
Lime	3347	3437
Shale & Lime	3437	3512
Lime	3512	3805
Shale & Lime	3805	3870

T. D. 3870

D. S. T. At 3864-3870 Tool open 1 Hr. 20 Min. shut in.

Recovered 2370<sup>gals</sup> of Salt Water.

Test well Dry and abandoned.

STATE OF KANSAS  
 NOTARY PUBLIC  
 3010

PLUGGING  
 FILE SEC 4 T 22 R 16W  
 BOOK PAGE 57 LINE 44

STATE OF KANSAS )  
 ) SS.  
 BARTON COUNTY )

Jim Adkins, of lawful age deposes and says that he is President of Adkins Drilling Company, Inc. of Great Bend, Kansas, and that the foregoing is a true and correct copy of Drillers Log on above well to the best of his knowledge.

Jim Adkins  
 Notary Public.

Subscribed and sworn to before me this 30th day of October 1957.