


STATE OF KANSAS
STATE CORPORATION COMMISSION

Give All Information Completely
Make Required Affidavit
Mail or Deliver Report to:
Conservation Division
State Corporation Commission
800 Bittling Building
Wichita, Kansas

WELL PLUGGING RECORD

NORTH

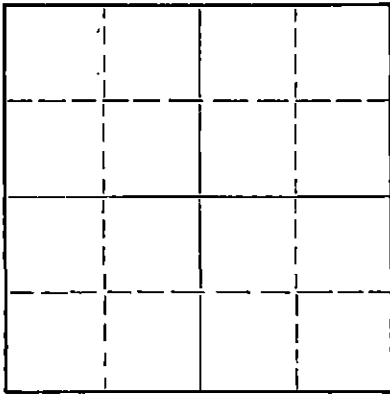

Locate well correctly on above
Section Plat

Pawnee County. Sec. 4 Twp. 22S Rge. (E) 16 (W)
Location as "NE/CNW&SW" or footage from lines 1710' fwl and 1737' fsl
Lease Owner A. F. BRANN
Lease Name BAXTER Well No. 1
Office Address 518 Petroleum Building, Wichita, Kansas
Character of Well (completed as Oil, Gas or Dry Hole) Dry Hole
Date well completed May 21, 1956
Application for plugging filed verbally - May 20, 1956
Application for plugging approved verbally - May 20, 1956
Plugging commenced May 21, 1956
Plugging completed May 21, 1956
Reason for abandonment of well or producing formation Dry

If a producing well is abandoned, date of last production 19
Was permission obtained from the Conservation Division or its agents before plugging was commenced? verbally - yes

Name of Conservation Agent who supervised plugging of this well _____
Producing formation _____ Depth to top _____ Bottom _____ Total Depth of Well 3868' Feet
Show depth and thickness of all water, oil and gas formations.

OIL, GAS OR WATER RECORDS

CASING RECORD

FORMATION	CONTENT	FROM	TO	SIZE	PUT IN	PULLED OUT
				8-5/8"	982'	

Describe in detail the manner in which the well was plugged, indicating where the mud fluid was placed and the method or methods used in introducing it into the hole. If cement or other plugs were used, state the character of same and depth placed, from _____ feet to _____ feet for each plug set.

Filled hole with heavy mud to 330'
1st Plug set at 330' with 1/3 sack hulls & 25 sx cement.
Filled hole with heavy mud to 40'.
2nd Plug set at 40' with 1/3 sack hulls & 15 sx cement.

(If additional description is necessary, use BACK of this sheet)
Name of Plugging Contractor Musgrove Petroleum Corporation
Address 518 Petroleum Building, Wichita, Kansas.

STATE OF Kansas COUNTY OF Sedgwick
I, Gordon L. Koelling (employee of owner) or (owner) or (operator) of the above-described well, being first duly sworn on oath, says: That I have knowledge of the facts, statements, and matters herein contained and the log of the above-described well as filed and that the same are true and correct. So help me God.

(Signature) Gordon L. Koelling
518 Petroleum Building, Wichita, Kansas.
(Address)

SUBSCRIBED AND SWORN TO before me this 25th day of May, 1956

My commission expires June 16, 1959

Leon Joyce Hepler
Notary Public.

PLUGGING
FILE SEC 4 T 22 R 16W
BOOK PAGE 63 LINE 34

RECEIVED
STATE CORPORATION COMMISSION
JUN 14 1956 6-14-56
CONSERVATION DIVISION
Wichita, Kansas

CONTRACTOR'S WELL LOG

COMPANY:	A. F. BRANN
CONTRACTOR:	Musgrove Petroleum Corporation
FARM:	BAXTER #1
LOCATION:	1710' from West line 1737' from South line Sec. 4-22-16W, Pawnee County, Ks.
COMMENCED:	May 10, 1956
COMPLETED:	May 21, 1956

0	128	Surface soil & shale
128	430	Shale & shells
430	520	Sand
520	810	Shale & shells
810	972	Shale
972	982	Anhydrite
982	1705	Shale
1705	1905	Shale & lime streaks
1905	2040	Lime & shale
2040	2140	Lime
2140	3510	Lime & shale
3510	3595	Lime
3595	3665	Lime & shale
3665	3772	Lime
3772	3830	Lime & shale
3830	3868	Lime
	3868	Rotary Total Depth

Set 8-5/8" surface casing at 982' w/500 sacks Pozmix, 2% calcium chloride.
Dry and Abandoned.

STATE OF KANSAS }
COUNTY OF SEDGWICK } SS

I, GORDON L. KOELLING, do hereby certify that the above and foregoing is a true and correct copy of the log of the BAXTER #1, located 1710' from the west line, and 1737' from the south line of Section 4-22-16W Pawnee County, Kansas, as reflected by the files of the Musgrove Petroleum Corporation.

MUSGROVE PETROLEUM CORPORATION

By Gordon L. Koelling
Secretary-Treasurer

Subscribed and sworn to before me, a Notary Public, in and for Sedgwick County, Kansas, this 25th day of May, 1956.

Notary Public

My commission expires June 16, 1959.

PLUGGING
FILE SEC. 4 T. 22 R. 16W
BOOK PAGE 63 LINE 34