


Give All Information Completely
Make Required Affidavit
Mail or Deliver Report to:
Conservation Division
State Corporation Commission
212 North Market, Insurance Bldg.
Wichita, Kansas

WELL PLUGGING RECORD

Pawnee County, Sec. 4 Twp. 22 Rge. 16 (E) W (W)

Location as "NE/CNW/SW" or footage from lines N/2 N/2 NW/4
Lease Owner Petroleum Management, Inc.
Lease Name Keast Well No. 1
Office Address Wichita, Kansas
Character of Well (completed as Oil, Gas or Dry Hole) _____
Date well completed _____ 19____
Application for plugging filed _____ 19____
Application for plugging approved _____ 19____
Plugging commenced 8-31-60 _____ 19____
Plugging completed 9-3-60 _____ 19____
Reason for abandonment of well or producing formation Depleted.

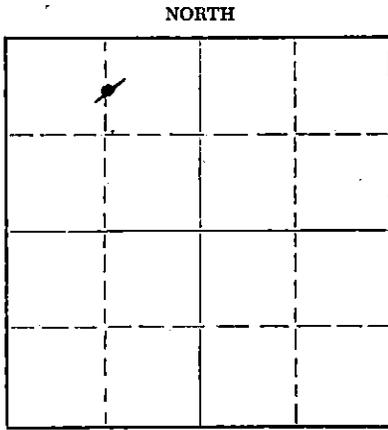

Locate well correctly on above Section Plat

If a producing well is abandoned, date of last production _____ 19____
Was permission obtained from the Conservation Division or its agents before plugging was commenced? YES

Name of Conservation Agent who supervised plugging of this well Frank Broadfoot.
Producing formation _____ Depth to top _____ Bottom _____ Total Depth of Well 3840 Feet
Show depth and thickness of all water, oil and gas formations.

OIL, GAS OR WATER RECORDS

CASING RECORD

FORMATION	CONTENT	FROM	TO	SIZE	PUT IN	PULLED OUT
				8-5/8"	979'	None
				5-1/2"	3839'	3038'

Describe in detail the manner in which the well was plugged, indicating where the mud fluid was placed and the method or methods used in introducing it into the hole. If cement or other plugs were used, state the character of same and depth placed, from _____ feet to _____ feet for each plug set.

Checked hole to 3840' and ran 10 gal. of sand to 3830'.
Dumped 5 sacks of cement with dump bailer. Pulled 5 1/2" casing. Had Globe Cementing Co. squeeze 100 sacks of cement and 40 bbl. mud to surface pipe.

PLUGGING COMPLETE.

RECEIVED
STATE CORPORATION COMMISSION
SEP 13 1960
9-13-60
CONSERVATION DIVISION
Wichita, Kansas

(If additional description is necessary, use BACK of this sheet)
Name of Plugging Contractor KNIGHT CASING PULLING CO.
Address CHASE, KANSAS

STATE OF KANSAS, COUNTY OF RICE, ss.
Noel J. Knight (employee of owner) or (~~owner or operator~~) of the above-described well, being first duly sworn on oath, says: That I have knowledge of the facts, statements, and matters herein contained and the log of the above-described well as filed and that the same are true and correct. So help me God.

(Signature) Noel J. Knight
Chase, Kansas
(Address)

SUBSCRIBED AND SWORN TO before me this 6th day of September, 19 60

Milton J. Volin
Notary Public.

My commission expires May 20, 1964





DRILLING COMPANY, INC. Forest 3-1279 352 N. BROADWAY WICHITA, KANSAS

Rocket Drilling Company, Inc.
 #1 Keast
 Approx. 1/2 1/2 NW/4 Sec. 22S-11W
 Pawnee County, Kansas

RECEIVED

Elevation: 1994 Gr.; 1991 D.P.; 1990 R.B.
 Spudded: April 8, 1956
 Rotary Completed: April 17, 1956
 Contractor: Rocket Drilling Company, Inc.

CASING RECORD

979' 8-5/8" O.D. 24# seamless casing cemented with 400 sacks cement.
 3839 1/2' 5-1/2" O.D. 14# seamless casing cemented with 120 sacks cement.

DRILLERS LOG

Sand & Clay	0 to 105	Sand	2030
Clay & Shale	115	Lime	2195
Sand	310	Sand	2205
Sand & Shale	605	Lime	2320
Sand	620	Lime & Shale	2430
Shale	973	Sand	2540
Anhydrite	995	Lime	2650
Shale & Shells	1460	Lime & Shale	3000
Shale & Salt	1770	Shale & Lime	3255
Lime & Shale	1844	Lime	3796
Salt & Lime	1985	Lime & Shale	3839
Lime	2020	Arbuckle	3840 T.D.

RECEIVED
 STATE CORPORATION COMMISSION

SEP 13 1960

CONSERVATION DIVISION
 Wichita, Kansas

STATE OF KANSAS)
 COUNTY OF SEDGWICK) SS

I hereby certify that to the best of my knowledge and belief the foregoing log is true and correct.

ROCKET DRILLING COMPANY, INC.

L.H. Myrick

Subscribed and sworn to before me, a Notary Public, in and for the County and State aforesaid, this 20th day of April, 1956.

My commission expires:
 10/28/1959

Notary Public