

STATE OF KANSAS
STATE CORPORATION COMMISSION


15-055-00169-0000
WELL PLUGGING RECORD

Give All Information Completely
Make Required Affidavit
Mail or Deliver Report to:
Conservation Division
State Corporation Commission
211 No. Broadway
Wichita, Kansas

Finney County. Sec. 4 Twp. 21S Rge. (E) 33 (W)

Location as "NE/CNW/SW" or footage from lines 50' E of C S/2
Lease Owner A. D. McKelvy
Lease Name Sandifer Well No. 4
Office Address 48 Lloyd Drive, Atherton, California
Character of Well (completed as Oil, Gas or Dry Hole) dry hole
Date well completed March 27 19 61
Application for plugging filed May 29, 1961 19 61
Application for plugging approved Approved by supervisor Apr. 23, 1961 19 61
Plugging commenced April 23, 1961 19 61
Plugging completed April 23, 1961 19 61
Reason for abandonment of well or producing formation dry hole

NORTH

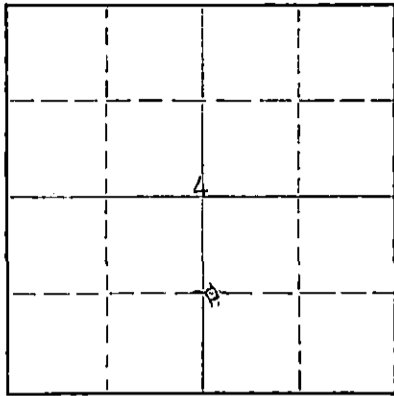

Locate well correctly on above Section Plat

If a producing well is abandoned, date of last production _____ 19 _____
Was permission obtained from the Conservation Division or its agents before plugging was commenced? yes

Name of Conservation Agent who supervised plugging of this well Frank Broadfoot, St. John, Kansas
Producing formation _____ Depth to top _____ Bottom _____ Total Depth of Well 2710 Feet
Show depth and thickness of all water, oil and gas formations.

OIL, GAS OR WATER RECORDS

CASING RECORD

FORMATION	CONTENT	FROM	TO	SIZE	PUT IN	PULLED OUT
				8 5/8	303.42'	none
				5 1/2	2716.64'	1630.88'

Describe in detail the manner in which the well was plugged, indicating where the mud fluid was placed and the method or methods used in introducing it into the hole. If cement or other plugs were used, state the character of same and depth placed, from _____ feet to _____ feet for each plug set.

Mudded hole to 285', set 10' rock bridge with 20 sacks cement. Mud to 40', set 10' rock bridge with 10 sacks cement to base of cellar.

RECEIVED
STATE CORPORATION COMMISSION

MAY 31 1961 05-31-61

CONSERVATION DIVISION
Wichita, Kansas

(If additional description is necessary, use BACK of this sheet)
Name of Plugging Contractor Graham-Michaelis Drilling Company
Address 211 North Broadway, Wichita 2, Kansas

STATE OF Kansas, COUNTY OF Sedgwick, ss.
Jack L. Yinger (employee of owner or operator) of the above-described well, being first duly sworn on oath, says: That I have knowledge of the facts, statements, and matters herein contained and the log of the above-described well as filed and that the same are true and correct. So help me God.

(Signature) Jack L. Yinger Jack L. Yinger
211 North Broadway, Wichita 2, Kansas
(Address)

SUBSCRIBED AND SWORN to before me this 29 day of May, 19 61

My commission expires December 12, 1962 Evelyn D. Evans Notary Public.



SANDIFER #4

WELL RECORD:

LOCATION:

SE/4 Section 4-21-33
Finney County, Kansas

Commenced: 3/24/61
Completed: 3/27/61
(Rotary)

CONTRACTOR:

Graham-Michaelis Drilling Co.
Liberal Division
P. O. Box 896
Liberal, Kansas

CASING RECORD:

11 Jts. 8 5/8" 8rd Thrd 24# Casing
Cemented w/200 sx HA-5

	LOG	
Soil, Clay & Shale	0 -	250
Shale	250 -	350
Sand, Shale, Red Bed & Gyp	350 -	1430
Shale & Red Bed	1430 -	1578
Anhy	1578 -	1620
Sand & Shale	1620 -	2030
Shale, Anhy & Lime	2030 -	2525
Shale & Lime w/Anhy Streaks	2525 -	2660
Lime & Shale	2660 -	2710

2710' - Total Rotary Depth

The undersigned, Graham-Michaelis Drilling Company, Liberal Division, certifies that the above log is a true and correct copy of the formations encountered in drilling the above mentioned well, as taken from the Daily Drilling Report.

GRAHAM-MICHAELIS DRILLING COMPANY
LIBERAL DIVISION

By H. R. Michaelis
H. R. Michaelis

RECEIVED
STATE CORPORATION COMMISSION

MAY 31 1961

CONSERVATION DIVISION
Wichita, Kansas