

STATE CORPORATION COMMISSION


Give All Information Completely
 Make Required Affidavit
 Mail or Deliver Report to:
 Conservation Division
 State Corporation Commission
 211 No. Broadway
 Wichita, Kansas

WELL PLUGGING RECORD

15-097-00204-0000

Kiowa County, Sec. 9 Twp. 28S Rge. 16 (E) (W)

NORTH

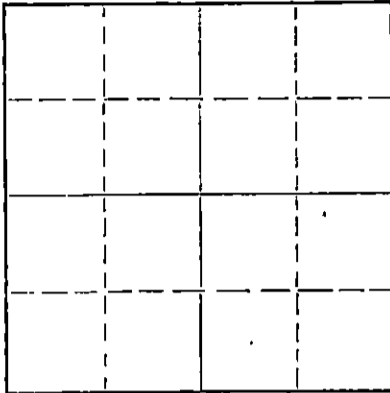

Locate well correctly on above Section Plat

Location as "NE/CNW/SW" or footage from lines C NW NW
 Lease Owner Bowers Drilling Company, Inc.
 Lease Name Davis Well No. 1
 Office Address 416 Union Center Building, Wichita, Kansas
 Character of Well (completed as Oil, Gas or Dry Hole) Dry Hole
 Date well completed 9-21-62 19
 Application for plugging filed 9-21-62 19
 Application for plugging approved 9-21-62 (Verbally) 19
 Plugging commenced 9-21-62 19
 Plugging completed 9-21-62 19
 Reason for abandonment of well or producing formation Dry Hole

If a producing well is abandoned, date of last production _____ 19
 Was permission obtained from the Conservation Division or its agents before plugging was commenced? Yes, verbally

Name of Conservation Agent who supervised plugging of this well _____
 Producing formation _____ Depth to top _____ Bottom _____ Total Depth of Well 4815 Feet
 Show depth and thickness of all water, oil and gas formations.

OIL, GAS OR WATER RECORDS

CASING RECORD

FORMATION	CONTENT	FROM	TO	SIZE	PUT IN	PULLED OUT
				8-5/8"	425'	

Describe in detail the manner in which the well was plugged, indicating where the mud fluid was placed and the method or methods used in introducing it into the hole. If cement or other plugs were used, state the character of same and depth placed, from _____ feet to _____ feet for each plug set.

Filled with heavy mud to 350'
 Set 1st plug at 350' w/20 sacks
 Filled with heavy mud to 35'
 Set 2nd plug at 35' w/10 sacks cement

RECEIVED
 STATE CORPORATION COMMISSION

SEP 26 1962 9-26-62

CONSERVATION DIVISION
 Wichita, Kansas

(If additional description is necessary, use BACK of this sheet)
 Name of Plugging Contractor Bowers Drilling Company, Inc.
 Address 416 Union Center Building, Wichita, Kansas

STATE OF KANSAS, COUNTY OF SEDGWICK, ss.

(employer of owner) or (owner or operator) of the above-described well, being first duly sworn on oath, says: That I have knowledge of the facts, statements, and matters herein contained and the log of the above-described well as filed and that the same are true and correct. So help me God.

(Signature) Emil E. Bowers
416 Union Center Bldg., Wichita, Kansas
 (Address)

SUBSCRIBED AND SWORN TO before me this 25th day of September, 19 62

My commission expires May 1, 1966

Hanna J. Miller
 Notary Public.

WELL LOG

COMPANY: Bowers Drilling Company, Inc.
CONTRACTOR: Bowers Drilling Company, Inc.
FARM: Davis #1
LOCATION: C. NW NW Section 9-28S-16W
 Kiowa County, Kansas
COMMENCED: 9-8-62
COMPLETED: 9-21-62
ELEVATION: 2138 K. B.

0	-	425	Sand-Shale
425	-	1050	Redbed and Shale
1050	-	1295	Shale
1295	-	1385	Shale and Shells
1385	-	2150	Shale
2150	-	4430	Lime and Shale
4430	-	4655	Lime
4655	-	4640	Lime and Shale
4640	-	4680	Lime
4680	-	4707	Sand and Chert
4707	-	4715	Chert
4715	-	4740	Chert - Lime
4740	-	4770	Sand & Chert
4770	-	4815	Chert
4815			T. D.

Set 8-5/8" casing at 425'

LOG TOPS:

Heebner	3978	Lansing	4155	Miss. Chert	4677
Toronto	3995	Base/K. C.	4464	Kinderhook Sand	4720
Douglas	4010	Marmaton	4480	Kinderhook Chert	4753
Brown Lime	4136	Cherokee Shale	4643	Viola	4779
		Cherokee Sand	4666		

STATE OF KANSAS)
) SS
 COUNTY OF SEDGWICK)

I, Emil E. Bowers, do hereby certify that the above and foregoing is a true and correct copy of the copy of the log of the Davis #1, C NW NW Section 9-28S-16W, Kiowa County, Kansas, as reflected by the files of Bowers Drilling Company, Inc.

Emil E. Bowers
 Emil E. Bowers

Subscribed and sworn to before me, a Notary Public in and for Sedgwick County, Kansas, this _____ day of September, 1962.

Donna F. Miller
 Donna F. Miller, Notary Public

My commission expires May 1, 1966.