


Give All Information Completely
Make Required Affidavit
Mail or Deliver Report to:
Conservation Division
State Corporation Commission
211 No. Broadway
Wichita, Kansas

WELL PLUGGING RECORD

NORTH

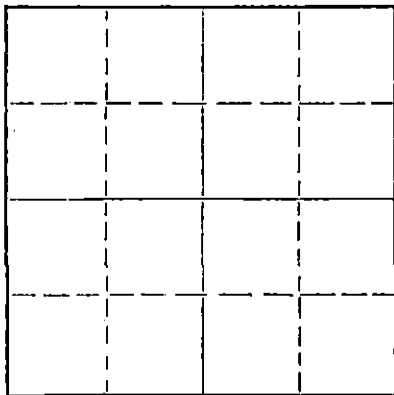

Locate well correctly on above
Section Plat

Stafford County. Sec. 14 Twp. 22S Rge. 14 (X) (W)
Location as "NE/CNW/SE" or footage from lines NW SE NW
Lease Owner Wilkinson Drilling, Inc.
Lease Name McBride Well No. 1
Office Address 1121 Union Nat'l. Bldg. - Wichita 2, Kansas
Character of Well (completed as Oil, Gas or Dry Hole) Dry Hole
Date well completed 7-21 19 57
Application for plugging filed 7-20 19 57
Application for plugging approved 7-20 19 57
Plugging commenced 7-20 19 57
Plugging completed 7-20 19 57
Reason for abandonment of well or producing formation Dry Hole

If a producing well is abandoned, date of last production _____ 19____
Was permission obtained from the Conservation Division or its agents before plugging was commenced? Yes

Name of Conservation Agent who supervised plugging of this well Milton Galyardt
Producing formation _____ Depth to top _____ Bottom _____ Total Depth of Well 3850 Feet
Show depth and thickness of all water, oil and gas formations.

OIL, GAS OR WATER RECORDS

CASING RECORD

FORMATION	CONTENT	FROM	TO	SIZE	PUT IN	PULLED OUT

Describe in detail the manner in which the well was plugged, indicating where the mud fluid was placed and the method or methods used in introducing it into the hole. If cement or other plugs were used, state the character of same and depth placed, from _____ feet to _____ feet for each plug set.

Bottom plug set @ 290' - 1/2 sack hulls. Plug and set rock bridge.
Cement W/20 sacks cement. Top plug set @ 40' cemented W/10 sacks
cement. Job complete @ 12:00 Noon, July 20, 1957

RECEIVED
STATE CORPORATION COMMISSION

AUG 24 1957

CONSERVATION DIVISION
Wichita, Kansas

8-24-57

(If additional description is necessary, use BACK of this sheet)

Name of Plugging Contractor Wilkinson Drilling, Inc.
Address 1121 Union National Building - Wichita 2, Kansas

STATE OF Kansas, COUNTY OF Sedgwick, ss.
Walter M. Wilkinson (~~employee of owner~~) or (owner or operator) of the above-described well, being first duly sworn on oath, says: That I have knowledge of the facts, statements, and matters herein contained and the log of the above-described well as filed and that the same are true and correct. So help me God.

(Signature) Walter M. Wilkinson
1121 Union Nat'l. Bldg. - Wichita 2, Kansas
(Address)

SUBSCRIBED AND SWORN to before me this 23rd. day of August, 19 57

Carolyn F. Moore
Notary Public.

My Commission expires January 2, 1961.

PLUGGING
FILE SEC 14 T 22R 14W
BOOK PAGE 30 LINE 28

WILKINSON DRILLING INCORPORATED

1121 UNION NATIONAL BUILDING
WICHITA 2, KANSAS

MC BRIDE #1

Company	- Wilkinson Drilling, Inc.	Location:	NW SE NE, Sec. 14-22S-14W,
Contractor	- Company Tools		Stafford County, Kansas.
Commenced	- 7-5-57	Casing:	318.35' - 8 5/8"
Completed	- 7-21-57	Elevation:	1949 RB
Total Depth	- 3850'		

FIGURES INDICATE BOTTOMS OF FORMATION

Depth	Formation
0 - 120	Sand
120 - 285	Sand & Clay
285 - 299	Blue Shale
299 - 789	Sand, Shale & Red Bed
789 - 840	Anhydrite
840 - 1780	Shale & Shells
1780 - 2365	Shale & Lime
2365 - 2510	Lime & Shale
2510 - 3285	Shale & Lime
3285 - 3490	Lime & Shale
3490 - 3700	Lime
3700 - 3732	Viola Limestone
3732 - 3794	Simpson Shale
3794 - 3850	Arbuckle - Dolomite
3850 - T. D.	

We hereby certify the above and foregoing to be a true and correct copy of the Log on the McBride #1, located in the NW SE NE, Section 14-22S-14W, Stafford County, Kansas.

WILKINSON DRILLING, INCORPORATED

Walter M. Wilkinson
Walter M. Wilkinson

Subscribed and sworn to before me this 23rd. day of August, 1957.

Carolyn K. Moore
Notary Public

My commission expires January 2, 1961.

RECEIVED
STATE CORPORATION COMMISSION

AUG 24 1957
8-24-57
CONSERVATION DIVISION
Wichita, Kansas

PLUGGING

FILE SEC 14 T 22 R 14W
BOOK PAGE 30 LINE 28