


WELL PLUGGING RECORD

Give All Information Completely  
Make Required Affidavit  
Mail or Deliver Report to:  
Conservation Division  
State Corporation Commission  
800 Bittling Building  
Wichita, Kansas

Stafford County, Sec. 13 Twp 22-S Rge 14 (W)

Location as "NE/CNW $\frac{1}{4}$ /SW $\frac{1}{4}$ " or footage from lines ~~NE 1/4 SE 1/4 NE~~  
Lease Owner Carl Lebsack  
Lease Name Wright Well No. 1  
Office Address Box 308, Hays, Kansas  
Character of Well (completed as Oil, Gas or Dry Hole) Dry Hole  
Date well completed 4-9-52  
Application for plugging filed 4-9-19 52  
Application for plugging approved 4-9-19 52  
Plugging commenced 4-9-19 52  
Plugging completed 4-9-19 52  
Reason for abandonment of well or producing formation dry

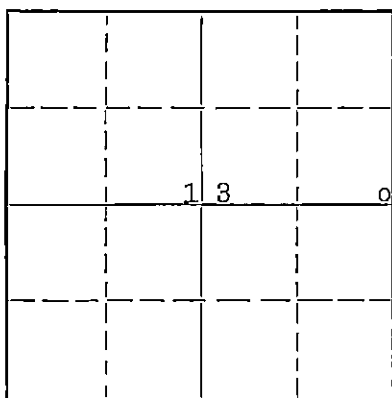

Locate well correctly on above Section Plat

If a producing well is abandoned, date of last production 19  
Was permission obtained from the Conservation Division or its agents before plugging was commenced? yes

Name of Conservation Agent who supervised plugging of this well M. A. Rives  
Producing formation Depth to top Bottom Total Depth of Well 3888 Feet  
Show depth and thickness of all water, oil and gas formations.

OIL, GAS OR WATER RECORDS

CASING RECORD

Formation	Content	From	To	Size	Put In	Pulled Out
		0	334	8 5/8"	334	None

Describe in detail the manner in which the well was plugged, indicating where the mud fluid was placed and the method or methods used in introducing it into the hole. If cement or other plugs were used, state the character of same and depth placed, from feet to feet for each plug set.

3888' back to 300' with heavy rotary mud. One plug with 15 sacks cement placed through drill pipe. From 300' back to 40' heavy rotary mud. One plug with ten sacks cement.

(If additional description is necessary, use BACK of this sheet)

Name of Plugging Contractor Buick Drilling Inc.  
Address Box 331, St. John, Kansas


STATE OF Kansas, COUNTY OF Stafford, ss.  
H. R. Buick (employee of owner) or (owner or operator) of the above-described well, being first duly sworn on oath, says: That I have knowledge of the facts, statements, and matters herein contained and the log of the above-described well as filed and that the same are true and correct. So help me God.

(Signature) [Signature]  
St. John, Kansas (Address)

SUBSCRIBED AND SWORN TO before me this 10th day of April, 19 52.

[Signature] Notary Public.

My commission expires December 26, 1955

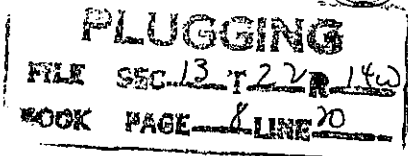

4-15-52

DRILLER'S LOG

Wright #1

Commenced R.D.: 3-27-52  
Completed R.D.: 4-9-52  
Total Depth: 3888'  
Casing Record 336' of 8 5/8"

~~SE SE NE~~  
~~NE SE SE~~  
Sec. 13-22S-14W  
Stafford County, Kansas  
Elevation: 1922 D. F.  
Initial Prod: None  
Contractor: Buick Drilling Inc.

STRATA	DEPTH
Surface Sand	0 - 50
Clay and Sand	50 - 130
Sand and Gravel	130 - 305
Gray Shale	305 - 334
Cement and Red Bed	334 - 400
Red Bed and Shale	400 - 795
Anhydrite	795 - 820
Shale and Shells	820 - 907
Shale, Red Bed, and Shells	907 - 1245
Salt, Shale, and Shells	1245 - 1565
Shale and Shells	1565 - 1760
Lime and Shale	1760 - 3568
Lime	3568 - 3658
Lime and Shale	3658 - 3742
Chert and Shale	3742 - 3806
Shale and Lime	3806 - 3878
Lime	3878 - 3888 T.D.

I hereby certify the above a true and correct drilling log as reflected by the drilling reports of the Buick Drilling Inc.

BUICK DRILLING INC.

H. R. Buick  
H. R. Buick, president

Signed and sworn to in my presence this \_\_\_\_\_ day of April, 1952, by H. R. Buick, President of the Buick Drilling Inc.

Roberta Shogren  
Notary Public

My Commission Expires: December 26, 1955

**PLUGGING**  
FILE SEC 13-22-14W  
BOOK PAGE 10