

STATE OF KANSAS
STATE CORPORATION COMMISSION
200 Colorado Derby Building
Wichita, Kansas 67202

WELL PLUGGING RECORD
K.A.R.-82-3-117

API NUMBER 15-185-10932-0000

LEASE NAME McMillan

WELL NUMBER A-1

TYPE OR PRINT
NOTICE: Fill out completely
and return to Cons. Div.
office within 30 days.

 Ft. from S Section Line

 Ft. from E Section Line

LEASE OPERATOR Phillips Petroleum Company

SEC. 13 TWP. 22S RGE. 14W (E) or (W)

ADDRESS RT #3 Box 20-A Great Bend, Ks. 67530

COUNTY Stafford

PHONE# (316) 793-8421 OPERATORS LICENSE NO. 5229

Date Well Completed 5-4-52

Character of Well SWD

Plugging Commenced

(Oil, Gas, D&A, SWD, Input, Water Supply Well)

Plugging Completed 11-4-91

The plugging proposal was approved on (date)

by (KCC District Agent's Name).

Is ACO-1 filed? If not, is well log attached?

Producing Formation Depth to Top Bottom T.D. 3785'

Show depth and thickness of all water, oil and gas formations.

11-7-91

OIL, GAS OR WATER RECORDS

CASING RECORD

Formation	Content	From	To	Size	Put In	Pulled out
				8 5/8"	375'	none
				5 1/2"	3775'	none

Describe in detail the manner in which the well was plugged, indicating where the mud fluid was placed and the method or methods used in introducing it into the hole. If cement or other plugs were used, state the character of same and depth placed, from feet to feet, each set.
Plugged with 300# hulls, 22 gel, 300 sacks 60/40 6% gel.

(If additional description is necessary, use BACK of this form.)

Name of Plugging Contractor KELSO CASING PULLING, INC. License No. 6050

Address P.O. Box 347 Chase, Kansas 67524

NAME OF PARTY RESPONSIBLE FOR PLUGGING FEES: Phillips Petroleum Company

STATE OF Kansas COUNTY OF Rice, ss.

R. Darrell Kelso (Employee of Operator) or (Operator) of above-described well, being first duly sworn on oath, says: That I have knowledge of the facts, statements, and matters herein contained and the log of the above-described well as filed that the same are true and correct, so help me God.

(Signature) *R. Darrell Kelso*

(Address) P.O. Box 347 Chase, KS. 67524

SUBSCRIBED AND SWORN TO before me this 5 day of November, 1991

My Commission Expires:



WELL SCHEMATIC

GL. 1928'
 DF 1930'
 KB 1932'
 PBD 3694'
 TD 3785'

WELL LOCATION

McMILLAN "A" NO. 1 STATUS SOIL
SE SW NW
SEC. 13-T22S-R14W
STAFFORD COUNTY OSCAR, NORTH FIELD
 SPUD 4-13-52
 COMPLETED 5-4-52
 IP 2911 BOPD, 59 BWPD 5/27/52

CASING

OD	WT	CEMENT	FROM	TO
8 5/8"	24#	350 SX WBC	375'	SURFA.
5 1/2"	14# H-40	1500 SX CMT	SET SURF	3775
		T.O.C	2620'	

TUBING

PERFS.


ZONE	TYPE	INTERVAL	SPE
ARRUCKLE	OPEN HOLE	3775-3785'	
LKC	22 gm	3636-3642	2.5 PI

LOGS

TYPE	DATE	COMPANY	FOOTAGE
LL	4/25/52	SCHLUMBERGER	3753-3776
IDT, N&I, CML, CAL, CRA	3/5/87	SCHLUMBERGER	3777-3785

WELL TEST FORMATIONS

DATE	BOPD	MCFGPD	BWPD
RED BED	378-805'		
ANHYDRITE	805-840'		
HEERNER	3283'		
TORONTO	3304'		
BROWN LS	3410'		
LKC	3423'		
BASE KC	3658		
VIOLA	3688		
SIMPSON	3722		
ARRUCKLE	3773		

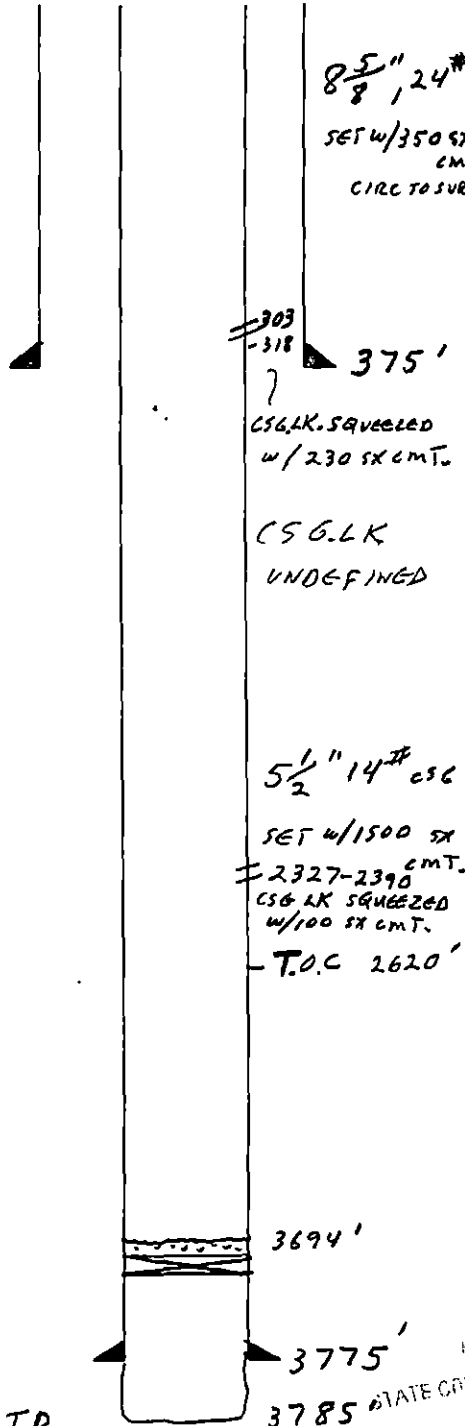

TD
 PREPARED BY: DAR
 DATE: 5/17/90

RECEIVED
 MAY 24 1990
 CONSERVATION DIVISION
 Wichita, Kansas