


WELL PLUGGING RECORD

Give All Information Completely
Make Required Affidavit
Mail or Deliver Report to:
Conservation Division
State Corporation Commission
800 Bittling Building
Wichita, Kansas.

NORTH

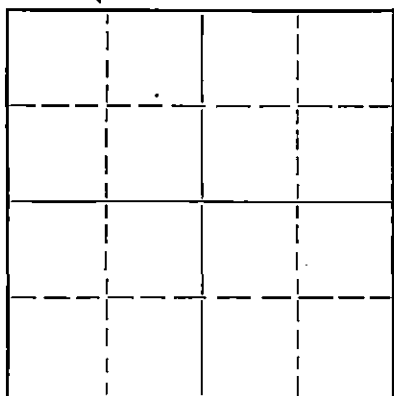

Locate well correctly on above Section Plat

Stafford County, Sec. 13 Twp. 22 Rge. 14 (W)
Location as "NE/CNW $\frac{1}{4}$ SW $\frac{1}{4}$ " or footage from lines NW $\frac{1}{4}$
Lease Owner Phillips Petroleum Company
Lease Name McMillan "A" Well No. 2
Office Address Box 779, Great Bend, Kansas
Character of Well (completed as Oil, Gas or Dry Hole) Dry Hole
Date well completed June 3, 1952
Application for plugging filed June 3, 1952
Application for plugging approved June 3, 1952
Plugging commenced June 3, 1952
Plugging completed June 3, 1952
Reason for abandonment of well or producing formation Dry hole

If a producing well is abandoned, date of last production 19...
Was permission obtained from the Conservation Division or its agents before plugging was commenced? Yes.

Name of Conservation Agent who supervised plugging of this well M. A. Rivas
Producing formation Arbuckle Depth to top 3922 Bottom 3970 Total Depth of Well 3970 Feet
Show depth and thickness of all water, oil and gas formations.

OIL, GAS OR WATER RECORDS

CASING RECORD

Formation	Content	From	To	Size	Put In	Pulled Out
Arbuckle	Dry	3922	3970	8-5/8"	368.64	None

Describe in detail the manner in which the well was plugged, indicating where the mud fluid was placed and the method or methods used in introducing it into the hole. If cement or other plugs were used, state the character of same and depth placed, from... feet to... feet for each plug set.

Spotted 75 sx. Howco cement 3970' to 3726'. Mudded hole 3726' to 327'. Set Howco plug at 327'. Spotted 15 sx. cement 327' to 282'. Mudded hole 282' to 35'. Set Howco plug at 35'. dumped 10 sx. cement 35' to base of cellar. Well plugged and abandoned 10:55 P.M. 6-3-52.

STATE CORPORATION COMMISSION
JUN 9 1952
CONSERVATION DIVISION

6-9-52

(If additional description is necessary, use BACK of this sheet)

Name of Plugging Contractor Sterling Drilling Company
Address Sterling, Kansas

STATE OF Kansas, COUNTY OF Barton, ss.
A. J. Willis (employee of owner) of the above-described well, being first duly sworn on oath, says: That I have knowledge of the facts, statements, and matters herein contained and the log of the above-described well as filed and that the same are true and correct. So help me God.

(Signature) *A. J. Willis*
Box 779, Great Bend, Kansas (Address)

SUBSCRIBED AND SWORN to before me this 4th day of June, 1952

My commission expires November 18, 1953

Joseph M. Beal
Notary Public.

23-8390's 8-51-20M
PLUGGING
FILE 137 242 1460
BOOK PAGE 21 JUNE 52

Formation Record

Lease McMillan "A"

Well No. 2

FROM	TO	Formation	REMARKS
0	170	Surface sand and shale.	
170	380	Sand, Red bed, and shells.	
380	810	Red bed.	
810	835	Anhydrite.	
835	1600	Shale.	
1600	1655	Lime, shale and shells.	
1655	1765	Lime and shale.	
1765	1960	Lime.	
1960	2080	Lime and shale.	
2080	2150	Lime.	
2150	2709	Lime and shale.	
2709	2795	Shale.	
2795	3143	Lime and shale.	
3143	3340	Shale.	
3340	3423	Lime and shale.	
3423	3670	Lime.	
3670	3745	Lime and shale.	
3745	3919	Shale.	
3919	3970	Lime.	Top Arbuckle 3922'.

PLUGGING RECEIVED
 STATE CORPORATION COMMISSION
 FILE SEC. 127 246 1860 JUN 9 - 1952
 BOOK PAGE 21 LINE 2
 CONSERVATION DIVISION
 Wichita, Kansas