


STATE OF KANSAS
STATE CORPORATION COMMISSION

WELL PLUGGING RECORD

Give All Information Completely
Make Required Affidavit
Mail or Deliver Report to:
Conservation Division
State Corporation Commission
800 Bitting Building
Wichita, Kansas

Stafford County, Sec. 13 Twp. 22S Rge. XEX 14 (W)

Location as "NE/CNW/SW" or footage from lines NW/4
Lease Owner Phillips Petroleum Company
Lease Name Rita Well No. 3
Office Address Box 779, Great Bend, Kansas
Character of Well (completed as Oil, Gas or Dry Hole) Dry Hole
Date well completed December 22, 1952
Application for plugging filed December 22, 1952
Application for plugging approved December 22, (Verbal) 1952
Plugging commenced December 22, 1952
Plugging completed December 22, 1952
Reason for abandonment of well or producing formation Dry Hole

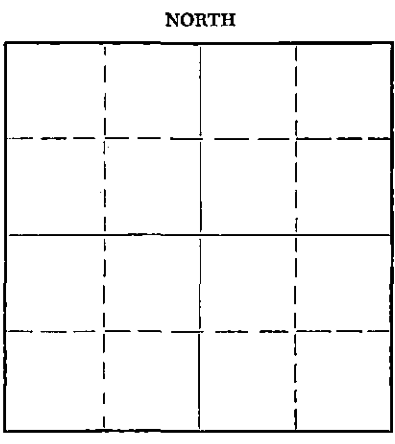

Locate well correctly on above Section Plat

If a producing well is abandoned, date of last production - - - - - 19 - -
Was permission obtained from the Conservation Division or its agents before plugging was commenced? Yes.

Name of Conservation Agent who supervised plugging of this well Mr. M. A. Rives
Producing formation - Depth to top - Bottom - Total Depth of Well 3856 Feet
Show depth and thickness of all water, oil and gas formations.

OIL, GAS OR WATER RECORDS

CASING RECORD

FORMATION	CONTENT	FROM	TO	SIZE	PUT IN	PULLED OUT
Arbuckle	Dry	3781	3856	8-5/8"	375.92' LT	None

Describe in detail the manner in which the well was plugged, indicating where the mud fluid was placed and the method or methods used in introducing it into the hole. If cement or other plugs were used, state the character of same and depth placed, from _____ feet to _____ feet for each plug set.

Mudded hole 3856' to 360'. Set Howco wood plug at 360'. Dumped 15 sx. cement to 300'. Filled with mud to 40'. Set Howco wood plug with 1/3 sack hulls on top. Dumped 10 sx. cement to base of cellar. Well plugged and abandoned 8:00 P.M. 12-22-52.

NOTE: Well Formation Record will be forwarded later.

(If additional description is necessary, use BACK of this sheet)

Name of Plugging Contractor Halliburton Oil Well Cementing Company
Address Duncan, Oklahoma

STATE OF Kansas, COUNTY OF Barton, ss.
A. J. Willis (employee of owner) or (~~owner or operator~~) of the above-described well, being first duly sworn on oath, says: That I have knowledge of the facts, statements, and matters herein contained and the log of the above-described well as filed and that the same are true and correct. So help me God.

(Signature) A. J. Willis
Box 779, Great Bend, Kansas
(Address)

SUBSCRIBED AND SWORN TO before me this 23rd day of December, 19 52

Franklin M. Reed
Notary Public.

My commission expires November 18, 1953

PLUGGING
PLK SEC 13 T 22S R 14
BOOK PAGE 69 LINE 1

24-2675-5 2-52-20M

RECEIVED
STATE CORPORATION COMMISSION
DEC 27 1952
CONSERVATION DIVISION
Wichita, Kansas

Formation Record

Lease Rita

Well No. 3

FROM	TO	Formation	REMARKS
0	315	Surface sand and shale.	
315	390	Shale.	
390	944	Shale and lime streaks.	
944	1517	Shale.	
1517	1863	Shale and lime.	
1863	2083	Ft. Riley lime and shale.	
2083	2486	Lime and shale.	
2486	2686	Shale and lime streaks.	
2686	2801	Shale and lime.	
2801	2960	Shale and lime streaks.	
2960	3423	Shale and lime.	
3423	3570	Lime.	
3570	3700	Lime and shale.	
3700	3741	Lime, chert, and shale.	
3741	3787	Shale and lime.	Top Arbuckle 3781'.
3787	3856	Lime.	

PLUGGING
 FILE SEC 13 122R 142
 BOOK PAGE 69 LINE 1

RECEIVED
 STATE COMMISSION
 DIVISION
 Wichita, Kansas