


STATE OF KANSAS
STATE CORPORATION COMMISSION

WELL PLUGGING RECORD

Give All Information Completely
Make Required Affidavit
Mail or Deliver Report to:
Conservation Division
State Corporation Commission
212 North Market, Insurance Bldg.
Wichita, Kansas

Pawnee County. Sec. 33 Twp. 22 Rge. 15 (E) (W)

Location as "NE/CNW/SW" or footage from lines SE NE NW
Lease Owner Natural Gas and Oil Company
Lease Name Koelsch Well No. 1
Office Address P. O. Box 105 - Great Bend, Kansas
Character of Well (completed as Oil, Gas or Dry Hole) Oil
Date well completed April 18 19 53
Application for plugging filed April 14 19 60
Application for plugging approved April 15 19 60
Plugging commenced May 5 19 60
Plugging completed May 10 19 60
Reason for abandonment of well or producing formation Depleted

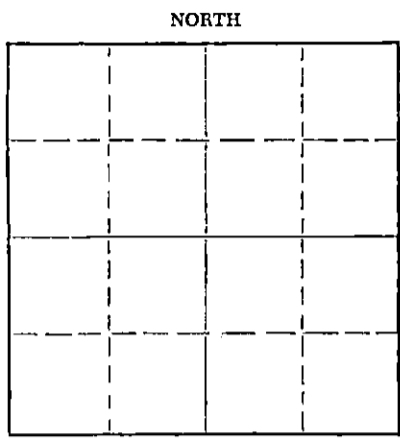

Locate well correctly on above Section Plat

If a producing well is abandoned, date of last production April 13 19 60
Was permission obtained from the Conservation Division or its agents before plugging was commenced? Yes

Name of Conservation Agent who supervised plugging of this well Frank Broadfoot
Producing formation Ians. K.C. Depth to top 3728 Bottom 3736 Total Depth of Well 4100 Feet
Show depth and thickness of all water, oil and gas formations.

OIL, GAS OR WATER RECORDS

CASING RECORD

FORMATION	CONTENT	FROM	TO	SIZE	PUT IN	PULLED OUT
				8-5/8"	202	None
				5-1/2"	3780	3205

Describe in detail the manner in which the well was plugged, indicating where the mud fluid was placed and the method or methods used in introducing it into the hole. If cement or other plugs were used, state the character of same and depth placed, from _____ feet to _____ feet for each plug set.

Sand to 3810 feet, pulled casing.
Pumped 65 sacks cement filling surface pipe
From 195 feet to base of cellar with cement.

RECEIVED
STATE CORPORATION COMMISSION

MAY 16 1960

CONSERVATION DIVISION
Wichita, Kansas

5-16-60

(If additional description is necessary, use BACK of this sheet)

Name of Plugging Contractor Southwest Casing Pulling Company, Inc.
Address P. O. Box 364 - Great Bend, Kansas

STATE OF KANSAS COUNTY OF BARTON, ss.
I, J. B. Steele, Jr. (employee of owner) ~~representative~~ of the above-described well, being first duly sworn on oath, says: That I have knowledge of the facts, statements, and matters herein contained and the log of the above-described well as filed and that the same are true and correct. So help me God.

(Signature) J. B. Steele, Jr.
P. O. Box 105 - Great Bend, Kansas
(Address)

SUBSCRIBED AND SWORN TO before me this 13th day of May, 19 60

Richard R. Brack
Notary Public.

My commission expires July 27, 1963

WELLS LOG

COMPANY: Mustang-Oremland Oil Company
 OPERATOR: Mustang Drilling Corporation
 WELL: Spelach #1, SE 1/4 Sec 33-25-15W,
 Pawnee County, Kansas
 STARTED: April 1, 1955 - Rotary
 April 17, 1955 - Washdown
 RESUMED: April 18, 1955 - Rotary
 April 18, 1955 - Washdown
 DEPTH: 3780

DEPTH	LOG

RECEIVED
 STATE CORPORATION COMMISSION
 APR 15 1960
 CONSERVATION DIVISION
 Wichita, Kansas

At 3780 feet at 8 1/8" surface pipe. Cemented with 200
 parts cement and 3 parts calcium chloride.

At 37' casing at 3780. Cemented with 75 parts cement.







CERTIFICATE

I, Jay Allen, do hereby certify that the above and foregoing is a true and correct copy of the log of the Section 51, 52 1/2 of Section 13-22-12N, Jackson County, Kansas, as reflected by files of the Hedgwick-Gremland Oil Company.

Jay Allen
Jay Allen

Subscribed and sworn to before me, a Notary Public, within and for Sedgewick County, Kansas, this 20th day of April, 1953.

Esther Trimmell
Esther Trimmell, Notary Public

My Commission expires May 03, 1955.

RECEIVED
STATE COMMISSION
APR 15 1960
CONSERVATION DIVISION
Wichita, Kansas