


STATE OF KANSAS
STATE CORPORATION COMMISSION

WELL PLUGGING RECORD

Give All Information Completely
Make Required Affidavit
Mail or Deliver Report to:
Conservation Division
State Corporation Commission
211 No. Broadway
Wichita, Kansas

Pawnee County. Sec. 33 Twp. 22 Rge. (E) 15 (W)
Location as "NE/CNW/SW" or footage from lines NE NE NW
Lease Owner I. Kornfeld, Wm. Glickann, Woodman & Iannitti Drlg. Co.
Lease Name Koelsch Well No. 1
Office Address 706 Union Nat'l. Bldg.
Character of Well (completed as Oil, Gas or Dry Hole) Dry Hole
Date well completed 6-8 19 65
Application for plugging filed 6-8 19 65
Application for plugging approved 6-8 19 65
Plugging commenced 6-8 19 65
Plugging completed 6-8 19 65
Reason for abandonment of well or producing formation Dry

NORTH

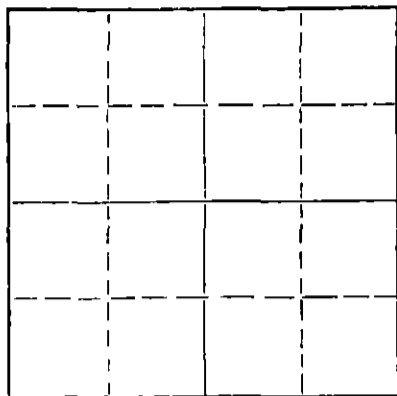

Locate well correctly on above
Section Plat

If a producing well is abandoned, date of last production 19
Was permission obtained from the Conservation Division or its agents before plugging was commenced? Yes

Name of Conservation Agent who supervised plugging of this well Eldon Petty
Producing formation _____ Depth to top _____ Bottom _____ Total Depth of Well 3800 Feet
Show depth and thickness of all water, oil and gas formations.

OIL, GAS OR WATER RECORDS

CASING RECORD

FORMATION	CONTENT	FROM	TO	SIZE	PUT IN	PULLED OUT
				8 5/8	190	

Describe in detail the manner in which the well was plugged, indicating where the mud fluid was placed and the method or methods used in introducing it into the hole. If cement or other plugs were used, state the character of same and depth placed, from _____ feet to _____ feet for each plug set.

Bottom plug @ 420' w/20 sx
Middle plug @ 180' w/20 sx
Top plug @ 35' w/10 sx

RECEIVED
STATE CORPORATION COMMISSION

JUN 10 1965

CONSERVATION DIVISION
Wichita, Kansas

6-10-65

(If additional description is necessary, use BACK of this sheet)
Name of Plugging Contractor Woodman & Iannitti Drilling Company
Address 706 Union Nat'l. Bldg.

STATE OF Kansas, COUNTY OF Sedgwick, ss.
K. T. Woodman (employee of owner) or (owner or operator) of the above-described well, being first duly sworn on oath, says: That I have knowledge of the facts, statements, and matters herein contained and the log of the above-described well as filed and that the same are true and correct. So help me God.

(Signature) K. T. Woodman
706 Union Nat'l. Bldg.
(Address)

SUBSCRIBED AND SWORN TO before me this 9 day of June, 19 65

My commission expires Feb. 11, 1968

Justina Chamberlain
Justina Chamberlain Notary Public.

Company: Irwin Kornfeld, Wm. B. Glickman, Woodman & Iannitti Drig. Co.
 Section: 33-22-15W
 Location: NE NE NW
 County: Pawnee
 Farms: Koelsch
 Total Depth: 3800'
 Comm: May 31, 1965
 Comp: June 8, 1965
 Contractor: Woodman & Iannitti Drilling Co.
 Casing: 8 5/8 @ 190' w/185 sx

Figures Indicate Bottom of Formation

60	Sand
100	Clay Red Bed
160	Red Bed
192	Blue Shale
395	Shale
480	Sand
940	Red Bed
1135	Shale
1680	Red Bed, Shale & Lime
1940	Shale & Lime
2055	Lime
2135	Lime
2245	Lime
2405	Lime
2505	Lime
2710	Lime & Shale
2860	Lime & Shale
2950	Lime
3120	Shale & Lime
3250	Lime
3315	Lime
3395	Lime
3475	Lime
3565	Lime
3576	Lime
3625	Lime
3705	Lime
3750	Lime
3790	Lime
3800	Total Depth

RECEIVED
 STATE CORPORATION COMMISSION
 JUN 10 1965
 CONSERVATION DIVISION
 Wichita, Kansas

I certify the above to be a true and correct copy of the driller's log and the geological tops to the best of my knowledge and belief.

Woodman & Iannitti Drilling Co.

By K. T. Woodman
K. T. Woodman