


Give All Information Completely
Make Required Affidavit
Mail or Deliver Report to:
Conservation Division
State Corporation Commission
800 Bittling Building
Wichita, Kansas

WELL PLUGGING RECORD

Pawnee County. Sec. 33 Twp. 22 Rge. (E) 15 (W)

Location as "NE/CNWSWK" or footage from lines NE SE NW
Lease Owner Natural Gas and Oil Corporation
Lease Name Koelsch Well No. 2
Office Address 1009 Central Building, Wichita 2, Kansas
Character of Well (completed as Oil, Gas or Dry Hole) dry hole
Date well completed September 2 19 53
Application for plugging filed (orally) September 2 19 53
Application for plugging approved (orally) September 2 19 53
Plugging commenced September 2, 1953 19
Plugging completed September 2, 1953 6 P M 19
Reason for abandonment of well or producing formation _____

NORTH

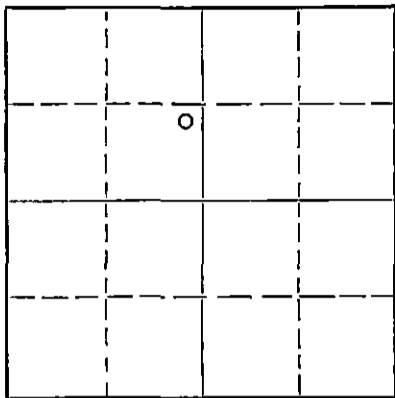

Locate well correctly on above Section Plat

If a producing well is abandoned, date of last production _____ 19____
Was permission obtained from the Conservation Division or its agents before plugging was commenced? yes

Name of Conservation Agent who supervised plugging of this well M. A. Rives, Box 148, Pratt, Kansas
Producing formation _____ Depth to top _____ Bottom _____ Total Depth of Well _____ Feet
Show depth and thickness of all water, oil and gas formations.

OIL, GAS OR WATER RECORDS

CASING RECORD

FORMATION	CONTENT	FROM	TO	SIZE	PUT IN	PULLED OUT
Surface		0	198	10 3/4"	198	none

Describe in detail the manner in which the well was plugged, indicating where the mud fluid was placed and the method or methods used in introducing it into the hole. If cement or other plugs were used, state the character of same and depth placed, from _____ feet to _____ feet for each plug set.
Filled hole with heavy mud from 4079 to 180 feet
Set plug and ran 30 sacks cement to 130 feet
Filled hole with heavy mud from 130 feet to 40 feet
Set plug at 130 feet ran 10 sacks cement and made good bridge.

RECEIVED
STATE CORPORATION COMMISSION
WICHITA, KANSAS
9-9-53

(If additional description is necessary, use BACK of this sheet)
Name of Plugging Contractor Drilling Department-Natural Gas and Oil Corporation
Address 1009 Central Building, Wichita 2, Kansas

STATE OF Kansas, COUNTY OF Sedgwick, ss.
Harold A. Burt (employee of owner) of the above-described well, being first duly sworn on oath, says: That I have knowledge of the facts, statements, and matters herein contained and the log of the above-described well as filed and that the same are true and correct. So help me God.
(Signature) Harold A. Burt
Regional Manager.
1009 Central Building, Wichita, Ks
(Address)

SUBSCRIBED AND SWORN TO before me this 8th day of September 19 53
Esther Russell
Notary Public.

My commission expires May 25, 1957
24-7966-S 3-53-20M

PLUGGING
FILE SEC 33 T 22 R 15W
BOOK PAGE 127 LINE 5

DRILLERS LOG

COMPANY: Natural Gas and Oil Corporation
 CONTRACTOR: Drilling Dept-Natural Gas and Oil Corp
 FARM: Koelsch #2, NE SE NW Sec 33-22S-15W
 Pawnee County, Kansas
 COMMENCED: August 13, 1953
 COMPLETED: September 2, 1953
 ELEVATION: 2004 RB.

0	to	90	Sand
90	to	175	Sand and shale
175	to	199	Shale
199	to	340	Shale- shells
340	to	410	Red bed - shale
410	to	490	Sand
490	to	515	Red bed
515	to	945	Shale and shells
945	to	975	Anhydrite
975	to	1535	Shale and shells
1535	to	1970	Shale and lime
1970	to	2215	Lime
2215	to	2535	Lime and shale
2535	to	2590	Lime
2590	to	3020	Shale and lime
3020	to	3065	Lime
3065	to	3115	Lime and shale
3115	to	3200	Lime
3200	to	3305	Lime and shale
3305	to	3325	Lime
3325	to	3375	Lime and shale
3375	to	3420	Lime
3420	to	3487	Lime and shale
3487	to	3559	Shale
3559	to	3564	Brown Lime
3564	to	3570	Shale
3570	to	3615	Lime
3615	to	3642	Lime and shale
3642	to	3748	Lime
3748	to	3798	Lime and shale
3798	to	3816	Shale
3816	to	3879	Shale and lime
3879	to	3913	Conglomerate
3913	to	3937	Shale and chert
3937	to	4008	Viola
4008	to	4041	Simpson
4041	to	4065	Lime and shale
4065	to	4075	Lime, shale and chert
4075	to	4079	Arbuckle
		4079	T. D.

Set 198 feet of 10 3/4" 32# surface. Cemented with 200 sacks cement and 4 sacks calcium chloride.

TOPS:	Anhydrite	945	Lansing	3566	Viola	3936
	Heeber	3438	Base KC	3800	Simpson	4001
	Brn Lime	3558	Conglomerate	3889	Arbuckle	4074

Drill Stem Tests:

- #1 3623-42, open 1 hr, rec. 60' slightly oil cut watery mud, 60' watery mud, FFP 90#, BHP 1210#.
- #2 3707-42, open 1 hr, fair blow thruout, rec. 240' muddy water, 120' sl. oil cut muddy water, IFP 180#, FFP 180#, BHP 1040#.
- #3 4011-4031, open 1 hour, shut in 15 min, rec. 35' mud, BHP 670#.

PLUGGING
 SEC 23 T 22 R 15W
 PAGE 127 LINE 5
 Schlumberger.

PLUGGED AND ABANDONED

CONSERVATION DIVISION
 Wichita, Kansas

C E R T I F I C A T E

I, Harold A. Burt, do hereby certify that the above and foregoing is a true and correct copy of the log of the Koelsch #2, NE SE NW Section 33-22S-15W, Pawnee County, Kansas, as reflected by files of the NATURAL GAS AND OIL CORPORATION.


Harold A. Burt

Subscribed and sworn to before me, a Notary Public, within and for Sedgwick County, Kansas, this 8th day of September, 1953.


Esther Unsell, Notary Public

My commission Expires May 25, 1957.