


15-185-19368-0000

STATE OF KANSAS
STATE CORPORATION COMMISSION

Give All Information Completely
Make Required Affidavit
Mail or Deliver Report to:
Conservation Division
State Corporation Commission
212 North Market, Insurance Bldg.
Wichita, Kansas

WELL PLUGGING RECORD

NORTH

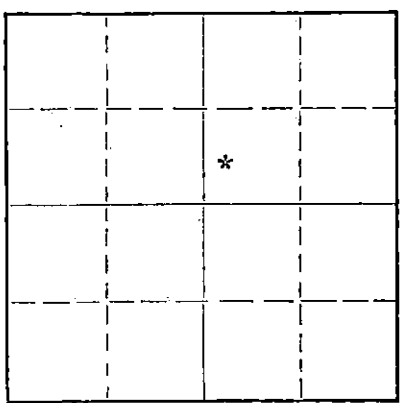

Locate well correctly on above
Section Plat

Stafford County. Sec. 4 Twp. 23 Rge. 12 (E) W (W)
Location as "NE/CNW%SW%" or footage from lines SW/NW/NE
Lease Owner E. H. Riggs
Lease Name Spangenberg Well No. 2
Office Address 1107 Union National Bldg., Wichita, Kansas
Character of Well (completed as Oil, Gas or Dry Hole) Dry Hole
Date well completed 9/22 19 64
Application for plugging filed 9/22 19 64
Application for plugging approved 9/22 19 64
Plugging commenced 9/22 19 64
Plugging completed 9/22 19 64
Reason for abandonment of well or producing formation Dry hole

If a producing well is abandoned, date of last production 19
Was permission obtained from the Conservation Division or its agents before plugging was commenced? yes

Name of Conservation Agent who supervised plugging of this well Archie Elving
Producing formation Depth to top Bottom Total Depth of Well 3734 Feet
Show depth and thickness of all water, oil and gas formations.

OIL, GAS OR WATER RECORDS

CASING RECORD

FORMATION	CONTENT	FROM	TO	SIZE	PUT IN	PULLED OUT

Describe in detail the manner in which the well was plugged, indicating where the mud fluid was placed and the method or methods used in introducing it into the hole. If cement or other plugs were used, state the character of same and depth placed, from feet to feet for each plug set.

Hole filled with mud to 240'. 1/4 sack hulls pushed down with plug-25 sacks cement through drill pipe. Hole filled to 40'. Hulls and plug pushed to 40'. cemented with 10 sacks cement to top.
Two sacks cement used to plug rat hole.

RECEIVED
STATE CORPORATION COMMISSION
SEP 29 1964
CONSERVATION DIVISION
Wichita, Kansas

(If additional description is necessary, use BACK of this sheet)
Name of Plugging Contractor A. L. Jackson Drilling Co.
Address P. O. Box 339, Great Bend, Kansas

STATE OF Kansas, COUNTY OF Barton, ss.
C. L. Miles, Contractor (employee of owner) or (owner or operator) of the above-described well, being first duly sworn on oath, says: That I have knowledge of the facts, statements, and matters herein contained and the log of the above-described well as filed and that the same are true and correct. So help me God.

(Signature) C. L. Miles
P. O. Box 339, Great Bend, Kansas
(Address)

SUBSCRIBED AND SWORN TO before me this 25th day of September, 19 64
My commission expires 5/9/67
Reata L. Boyd, Barton County Notary Public.
Kansas

C. L. Miles dba
A. L. JACKSON DRILLING COMPANY
P. O. Box 339
Great Bend Kansas

15-185-19369-0000

WELL LOG
Spangenberg #2
SW SE/NW/NE Sec. 4, Twp. 23, Rge. 12W
Stafford County Kansas

FROM	TO	
0	145	Sand
145	623	Red bed
623	647	anhydrite
647	1100	Red bed and shells
1100	1720	Lime and shale
1720	1980	Lime
1980	2815	Shale and lime
2815	2910	Lime
2910	3024	Shale and lime
3024	3159	Lime
3159	3350	Shale and lime
3350	3390	K. C. lime
3390	3423	Lime
3423	3602	Lime
3602	3630	Lime conglomerate
3630	3710	Lime
3710	3715	Arbuckle
3715	3734	Lime
3734	T.D.	Total Depth

RECEIVED
STATE CORPORATION COMMISSION

SEP 29 1964

CONSERVATION DIVISION
Wichita, Kansas

State of Kansas
County of Barton

C. L. Miles, dba A. L. Jackson Drilling Company, being first duly sworn on oath says: that I have knowledge of the facts, statements and matters herein contained and the log of the above described well as filed and that the same are true and correct.

C. L. Miles
C. L. Miles

My Commission Expires 5/9/67

Reata L. Boyd
Reata L. Boyd, Notary Public, Barton County, Ks.