


15-185-00024-0000

Give All Information Completely  
Make Required Affidavit  
Mail or Deliver Report to:  
Conservation Division  
State Corporation Commission  
800 Bitting Building  
Wichita, Kansas

WELL PLUGGING RECORD

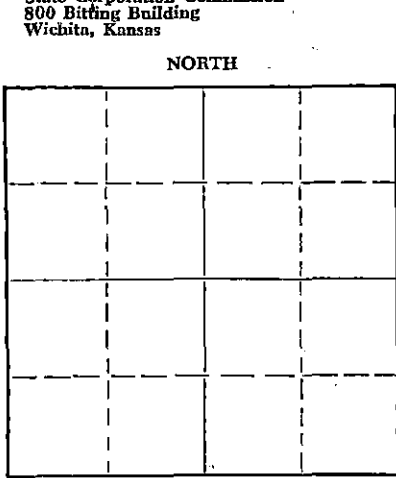

Locate well correctly on above Section Plat

Stafford County. Sec. 11 Twp. 23 Rge. 12 ~~12~~ (W)  
Location as "NE/CNW/SW" or footage from lines NE NW NW  
Lease Owner Alpine Oil & Royalty Co., Inc.  
Lease Name Hill Well No. 1  
Office Address 1100 Bitting Building, Wichita, Kansas  
Character of Well (completed as Oil, Gas or Dry Hole) Gas Well  
Date well completed October 20 19 52  
Application for plugging filed July 13 19 54  
Application for plugging approved July 13 19 54  
Plugging commenced July 22 19 54  
Plugging completed July 30 19 54  
Reason for abandonment of well or producing formation No market for gas

If a producing well is abandoned, date of last production \_\_\_\_\_ 19 \_\_\_\_\_  
Was permission obtained from the Conservation Division or its agents before plugging was commenced? Yes

Name of Conservation Agent who supervised plugging of this well Mr. M. A. Rives  
Producing formation \_\_\_\_\_ Depth to top \_\_\_\_\_ Bottom \_\_\_\_\_ Total Depth of Well 3656 Feet  
Show depth and thickness of all water, oil and gas formations. 3641

OIL, GAS OR WATER RECORDS

CASING RECORD

FORMATION	CONTENT	FROM	TO	SIZE	PUT IN	PULLED OUT
					8 5/8"	
					252'	None
				5 1/2"	3630'	2767'

Describe in detail the manner in which the well was plugged, indicating where the mud fluid was placed and the method or methods used in introducing it into the hole. If cement or other plugs were used, state the character of same and depth placed, from \_\_\_\_\_ feet to \_\_\_\_\_ feet for each plug set.

Sand bridge from 3500 feet to 3440 feet  
5 sacks of cement from 3440 to 3410 feet  
Mud from 3410 to 250 feet  
Rock bridge from 250 to 240 feet  
20 sacks of cement from 240 to 180 feet  
Mud from 180 to 35 feet  
10 sacks of cement from 35 feet to cellar

(If additional description is necessary, use BACK of this sheet)

Name of Plugging Contractor R. & S. Pipe Pulling Co.  
Address Box 192 Ellinwood, Kansas

STATE OF Kansas, COUNTY OF Sedgwick, ss.  
Thomas M. McCaul (employee of owner) or (owner or operator) of the above-described well, being first duly sworn on oath, says: That I have knowledge of the facts, statements, and matters herein contained and the log of the above-described well as filed and that the same are true and correct. So help me God.

(Signature) Thomas M. McCaul  
1100 Bitting Building, Wichita, Kansas (Address)  
August 5th day of August, 1954  
SUBSCRIBED AND SWORN TO before me this 5th day of August, 1954  
My commission expires August 10, 1957  
Notary Public. Virginia D. Murrell  
Wichita, Kansas

RECEIVED  
STATE CORPORATION COMMISSION  
AUG 6 - 1954  
CONSERVATION DIVISION  
Wichita, Kansas

8-6-54

PLUGGING  
FILE SEC. 11 TWP. 23 R. 12 W.  
PAGE 48 LINE 17.

WELL LOG

15-185-60024-0000

Alpine Oil & Royalty Co., Inc.

Elevation: 1834 R.B.

Contractor: Quaker Drilling Co., Inc.

Commenced: 9-24-52

Completed: 10-20-52

Hill No. 1  
NE NW NW Sec. 11-23S-12W  
Stafford County, Kansas

Production: Gas Well  
4 mil - 700 cu. ft. gas

Casing Record:

252' of 8 5/8" with 175 sacks cement

5 1/2" @ 3630' with 150 sacks cement

(Figures Indicate Bottom of Formations)

<u>FORMATION</u>	<u>DEPTH</u>	<u>FORMATION TOPS</u>	
Sand	140	Anhydrite	580 +1256
Gray Shale & Red Bed & Shells	210	Heebner	3119 -1285
Shale	252	Brown Lime	3256 -1422
Red Bed & Shells	580	Lansing	3282 -1448
Anhydrite	620	Conglomerate	3556 -1712
Shale & Shells	1515	Simpson	3574 -1740
Lime & Shale	2160	Arbuckle	3626 -1792
Broken Lime	2285	Total Depth	3656
Lime & Shale	3270		
Lime	3323		
Lime & Shale	3637		

I hereby certify that the above is a true and correct copy of Driller's Log of well drilled in the NE NW NW of Section 11, Township 23 South, Range 12 West, Stafford County, Kansas.

ALPINE OIL & ROYALTY CO., INC.

By: Thomas M. M. Cull  
President

Subscribed and sworn to before me this 23rd day of October, 1952.

Wesley Bell  
Notary Public

My commission expires: Sept. 14, 1953

RECEIVED  
STATE CORPORATION COMMISSION  
AUG 6 - 1952  
CONSERVATION  
Wichita

PLUGGING  
FILE SEC 11-23 R 124  
BOOK PAGE 48 LINE 17