


WELL PLUGGING RECORD

Give All Information Completely
Make Required Affidavit
Mail or Deliver Report to:
Conservation Division
State Corporation Commission
212 No. Market
Wichita, Kansas

NORTH

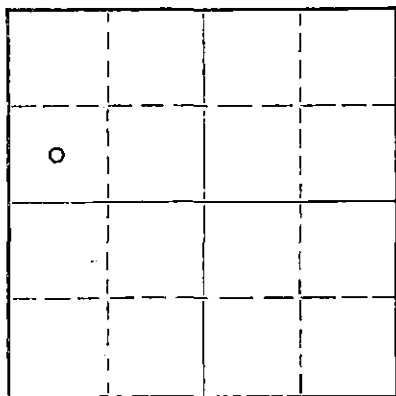

Locate well correctly on above
Section Plat

Hodgeman County. Sec. 8 Twp. 22 Rge. 22 (E) W (W)
Location as "NE/CNW%SW%" or footage from lines C SW¹ NW
Lease Owner Sun Oil Company
Lease Name Gustav Miller Well No. 2
Office Address 1720 S. Bellaire, Suite 300, Denver, Colorado 80222
Character of Well (completed as Oil, Gas or Dry Hole) Oil
Date well completed 2-5 19 62
Application for plugging filed 12-16 19 74
Application for plugging approved 12-20 19 74
Plugging commenced 1-10 19 75
Plugging completed 1-28 19 75
Reason for abandonment of well or producing formation State regulations
require plugging

If a producing well is abandoned, date of last production _____ 19 ____
Was permission obtained from the Conservation Division or its agents before plugging was commenced? Yes

Name of Conservation Agent who supervised plugging of this well Clarence F. Thomas
Producing formation Mississippi Depth to top 4517 Bottom 4522 Total Depth of Well 4620 Feet
Show depth and thickness of all water, oil and gas formations.

OIL, GAS OR WATER RECORDS

CASING RECORD

FORMATION	CONTENT	FROM	TO	SIZE	PUT IN	PULLED OUT
		0	258	8 5/8	258	0
		0	4617	5 1/2	4617	1945

Describe in detail the manner in which the well was plugged, indicating where the mud fluid was placed and the method or methods used in introducing it into the hole. If cement or other plugs were used, state the character of same and depth placed, from _____ feet to _____ feet for each plug set.

Dumped 30 gallons of sand across the perforations. Pulled 60 joints of 5 1/2" casing/ Displaced hole with 2 sacks of hulls, 50 sacks of cement, 10 sacks of gel, 35 sacks of cement, 10 sacks of gel. Released plug and displaced hole with 10 sacks of cement. Capped to surface.

RECEIVED
STATE CORPORATION COMMISSION
JAN 31 1975
1-31-75
CONSERVATION DIVISION
Wichita, Kansas

(If additional description is necessary, use BACK of this sheet)

Name of Plugging Contractor Charlie Crowe Drilling Company
Address P. O. Box 706 Hays, KS

STATE OF Colorado, COUNTY OF Denver, ss.
D. A. Coppedge (employee of owner) or (~~owner or operator~~) of the above-described well, being first duly sworn on oath, says: That I have knowledge of the facts, statements, and matters herein contained and the log of the above-described well as filed and that the same are true and correct. So help me God.

(Signature) [Signature]

(Address)

SUBSCRIBED AND SWORN TO before me this 29th day of January, 19 75

My commission expires Nov. 22, 1975
Mary Marson Notary Public.

WELL LOG

15.083-10236-0000

COMPANY **SUNRAY MID-CONTINENT OIL COMPANY**

SEC. 8 T. 22S R. 22W

FARM **GUS MILLER**

NO. 2

LOC. C-SW, NW


TOTAL DEPTH **4620'**

COUNTY **HODGEMAN CO., KANSAS**

COMM. **January 16, 1962** COMP. **January 29, 1962**

CONTRACTOR **GARVEY DRILLING COMPANY**

CASING **8-5/8" @ 265' w/200 sax.**
5 1/2" @ 4620' w/100 sax.

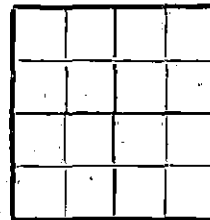

ELEVATION **2297' DF**

PRODUCTION

FIGURES INDICATE BOTTOM OF FORMATIONS

40	Surface soil & post rock
160	Shale & shells
470	Shale
835	Shale & red bed
854	Anhydrite
1240	Shale & sand
1461	Shale & red bed
1496	Anhydrite
2079	Shale & shells
2345	Shale & lime
2460	Lime & shale
2660	Lime
2800	Shale & lime
2905	Lime w/shale streaks
3140	Shale & lime
3520	Lime & shale
3605	Shale w/lime streaks
3850	Lime & shale
4390	Lime
4483	Shale & lime
4540	Lime & shale
4589	Cherty lime
4608	Chert, shale & lime
4620	Shale
4620	T. D.

RECEIVED
STATE CORPORATION COMMISSION
SEP 3 1974
CONSERVATION DIVISION
Wichita, Kansas

State of KANSAS

County of BARTON

I, VERNE A. MORRIS of GARVEY DRILLING COMPANY

upon oath state the above and foregoing is a true and correct copy of the log of the #2 GUS MILLER well.

Subscribed and sworn to before me this 16th day of February 1962

My Commission Expires: November 12, 1962

Verne A. Morris

NOTARY PUBLIC