


STATE OF KANSAS
STATE CORPORATION COMMISSION

Form CP-4

Give All Information Completely
Make Required Affidavit
Mail or Deliver Report to:
Conservation Division
State Corporation Commission
P. O. Box 17027
Wichita, Kansas 67217
NORTH

WELL PLUGGING RECORD

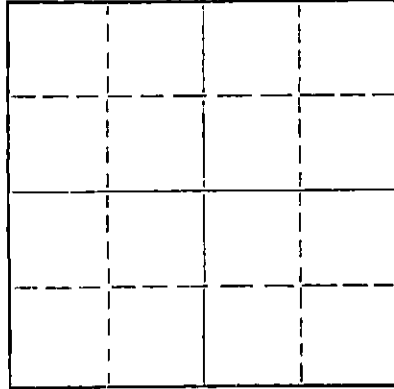

Locate well correctly on above
Section Plat

Hodgeman County, Sec. 8 Twp. 22 Rge. 22 (E) (W)
Location as "NE/CNW/SW" or footage from lines C NW SE
Lease Owner Specter Pipe & Supply Co., Inc
Lease Name Miller Estate Well No. 2
Office Address Box 169 Russell, Ks. 67665
Character of Well (completed as Oil, Gas or Dry Hole) oil
Date well completed 12-12-61 19
Application for plugging filed May 14, 1973 19
Application for plugging approved May 17, 1973 19
Plugging commenced 6/22 1973
Plugging completed 7/17 1973
Reason for abandonment of well or producing formation failure to produce
profitably
If a producing well is abandoned, date of last production 19
Was permission obtained from the Conservation Division or its agents before plugging was com-
menced? Yes

Name of Conservation Agent who supervised plugging of this well Edgar Eves
Producing formation Mississippi Depth to top 4533 Bottom 4540ft. Total Depth of Well 4547 Feet
Show depth and thickness of all water, oil and gas formations.

OIL, GAS OR WATER RECORDS

CASING RECORD

FORMATION	CONTENT	FROM	TO	SIZE	PUT IN	PULLED OUT
				8 5/8"	250'	0
				5 1/2"	4540'	3197'

Describe in detail the manner in which the well was plugged, indicating where the mud fluid was placed and the method or methods used in introducing it into the hole. If cement or other plugs were used, state the character of same and depth placed, from _____ feet to _____ feet for each plug set.
Filled with sand from 4547' to 4527'. Run 5 sacks cement from 4527' to 4497'.
Pumped 6 sacks gel mud & 120 sacks cement in 8 5/8" pipe to plug well.

STATE RECEIVED
JUL 25 1973
CONSERVATION DIVISION
Wichita, Kansas
7-25-73

(If additional description is necessary, use BACK of this sheet)
Name of Plugging Contractor Glenn's Pipe Pulling Co.
Address Box 156 Ellinwood, Kansas 67526

STATE OF Kansas, COUNTY OF Russell, ss.
Specter Pipe & Supply, Inc. (employee of owner) or (owner or operator) of the above-described well, being first duly sworn on oath, says: That I have knowledge of the facts, statements, and matters herein contained and the log of the above-described well as filed and that the same are true and correct. So help me God.

(Signature) [Signature]
Wichita, Kansas
(Address)

SUBSCRIBED AND SWORN TO before me this 20th day of July, 1973

[Signature]
Notary Public.

My commission expires May 21, 1973


WELL LOG BUREAU—KANSAS GEOLOGICAL SOCIETY
508 East Murdock, Wichita, Kansas

Company. SUNRAY MID-CONTINENT OIL CO.
Farm. Miller Estate No. 2

SEC. 8 T. 22 R. 22W
C NW SE

Total Depth. 4547'
Comm. 11-29-61 Comp. 12-12-61
Shot or Treated.
Contractor. Garvey Drlg. Co.
Issued. 3-31-62

County Hodgeman
KANSAS

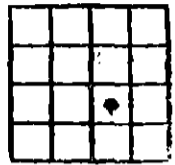

Elevation. 2307'

Production. 45 BOPD

CASING:

8 5/8" 250' cem w/200 sx.
5 1/2" 4540' cem w/100 sx.

Figures Indicate Bottom of Formations.

clay & post rock	50
shale	750
red bed	880
Anhydrite	894
shale & shells	975
shale & anhydrite	1580
shale & shells	2240
lime & shale	2430
shale & lime	2666
lime	2717
lime & shale	3914
lime	3970
lime & shale	4040
lime	4410
lime & shale	4479
lime	4544
lime	4547
Total Depth	

TOPS: SCOUT

Blaine	850
Stone Corral	1476
Lansing	3926
Base Kansas City	4224
Ft. Scott	4385
Mississippi	4533

RECEIVED
STATE CORPORATION COMMISSION

MAY 17 1973

CONSERVATION DIVISION
Wichita, Kansas