


STATE OF KANSAS
STATE CORPORATION COMMISSION

WELL PLUGGING RECORD

Give All Information Completely
Make Required Affidavit
Mail or Deliver Report to:
Conservation Division
State Corporation Commission
212 North Market, Insurance Bldg.
Wichita, Kansas

STAFFORD County. Sec. 18 Twp. 22S Rge. 11 (S) (W)
Location as "NE/CNW*SW*" or footage from lines SE SE NE
Lease Owner WESTERN PETROLEUM CO., INC.
Lease Name SHAFFER Well No. 1
Office Address 925 PATTON ROAD, GREAT BEND, KANSAS
Character of Well (completed as Oil, Gas or Dry Hole) DRY HOLE
Date well completed 2-25 1961
Application for plugging filed 2-24 1961
Application for plugging approved 2-24 1961
Plugging commenced 2-25 1961
Plugging completed 2-25 1961
Reason for abandonment of well or producing formation DRY HOLE

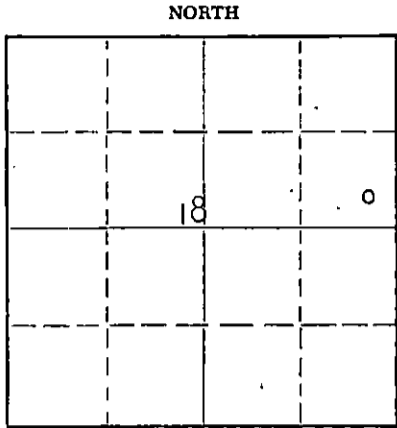

Locate well correctly on above
Section Plat

If a producing well is abandoned, date of last production ----- 19____
Was permission obtained from the Conservation Division or its agents before plugging was commenced? YES

Name of Conservation Agent who supervised plugging of this well FRANK BROADFOOT
Producing formation NONE Depth to top -- Bottom -- Total Depth of Well 3675 Feet
Show depth and thickness of all water, oil and gas formations.

OIL, GAS OR WATER RECORDS

CASING RECORD

FORMATION	CONTENT	FROM	TO	SIZE	PUT IN	PULLED OUT
D AND A						

Describe in detail the manner in which the well was plugged, indicating where the mud fluid was placed and the method or methods used in introducing it into the hole. If cement or other plugs were used, state the character of same and depth placed, from _____ feet to _____ feet for each plug set.

HOLE WAS FILLED WITH MUD TO BOTTOM, PLUG SET AT 240'. MIXED 20 SACKS CEMENT AND PUT ON TOP OF PLUG. FILLED HOLE WITH HEAVY MUD TO 35', SET PLUG. POURED 10 SACKS CEMENT ON TOP OF PLUG. COMPLETED 10:00 AM, 2/25/61

RECEIVED
STATE CORPORATION COMMISSION

MAR 1 1961

CONSERVATION DIVISION
Wichita, Kansas

3-1-61

(If additional description is necessary, use BACK of this sheet)
Name of Plugging Contractor WESTERN PETROLEUM CO., INC.
Address 925 PATTON ROAD, GREAT BEND, KANSAS

STATE OF KANSAS, COUNTY OF BARTON, ss.
JOHN H. VOLOSIN (employee of owner) or (owner/operator) of the above-described well, being first duly sworn on oath, says: That I have knowledge of the facts, statements, and matters herein contained and the log of the above-described well as filed and that the same are true and correct. So help me God.
(Signature) *John H. Volosin*
JOHN H. VOLOSIN
925 PATTON ROAD (Address)

SUBSCRIBED AND SWORN TO before me this 27 day of FEBRUARY, 1961

Reva C. Brown
REVA C. BROWN Notary Public.

My commission expires JANUARY 15, 1961



DRILLER'S LOG

COMPANY: WESTERN PETROLEUM Co., INC. LOCATION: SE SE NE
 CONTRACTOR: WESTERN PETROLEUM Co., INC. SEC. 18, T22S, R11W
 STAFFORD COUNTY, KANSAS
 FARM NAME: SHAFFER ELEVATION: 1815 K. B.
 COMMENCED: FEBRUARY 13, 1961 CASING USED: 8-5/8" @ 250' w/ 275
 SACKS POZMIX + 2% C.C.
 COMPLETED: FEBRUARY 25, 1961

SAND	45
SHALE	170
RED BED	561
ANHYDRITE	583
SHALE AND SHELLS	930
LIME AND SHALE	1465
SHALE AND LIME	1600
LIME AND SHALE	1860
SHALE AND LIME	2060
LIME AND SHALE	2595
SHALE AND LIME	2820
LIME AND SHALE	3087
SHALE AND LIME	3180
LIME AND SHALE	3245
LIME	3530
VIOLA	3560
LIME	3576
LIME, SHALE AND CHERT	3602
SHALE	3620
SHALE AND LIME	3630
LIME	3635
LIME AND SHALE	3640
LIME	3675
RTD	3675

RECEIVED
 STATE CORPORATION COMMISSION
 MAR 1 1961
 CONSERVATION DIVISION
 Wichita, Kansas

STATE OF KANSAS)
) ss
 COUNTY OF BARTON)

I, THE UNDERSIGNED, BEING DULY SWORN ON OATH, STATE THAT THE ABOVE STATEMENT AND LOG ARE TRUE AND A CORRECT RECORD AND LOG OF THE WELL DRILLED AT THE LOCATION ABOVE DESCRIBED.

WESTERN PETROLEUM CO., INC.

John H. Volosin
 JOHN H. VOLOSIN, GENERAL MANAGER

SUBSCRIBED AND SWORN TO BEFORE ME THIS 27TH DAY OF FEBRUARY, 1961

Reva C. Brown
 REVA C. BROWN, NOTARY PUBLIC

MY COMMISSION EXPIRES: JANUARY 15, 1963