

STATE OF KANSAS
STATE CORPORATION COMMISSION


WELL PLUGGING RECORD

Give All Information Completely
Make Required Affidavit
Mail or Deliver Report to:
Conservation Division
State Corporation Commission
800 Bitting Building
Wichita, Kansas

Stafford County, Sec. 18 Twp. 22S Rge. 11 W (W)

Location as "NE/CNW/SW" or footage from lines NW-NW-NW
Lease Owner Stearns Petroleum, Inc.
Lease Name Garvin Well No. 1
Office Address Box 313 - Russell, Kansas
Character of Well (completed as Oil, Gas or Dry Hole) Dry
Date well completed March 11 19 56
Application for plugging filed March 11 19 56
Application for plugging approved March 11 19 56
Plugging commenced March 11 19 56
Plugging completed 19
Reason for abandonment of well or producing formation Dry

NORTH

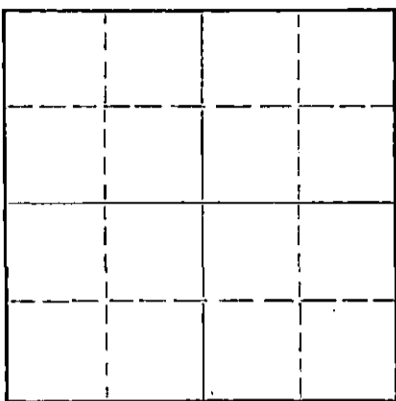

Locate well correctly on above Section Plat

If a producing well is abandoned, date of last production 19
Was permission obtained from the Conservation Division or its agents before plugging was commenced? YES

Name of Conservation Agent who supervised plugging of this well R. M. Brundage
Producing formation Depth to top Bottom Total Depth of Well 3695 Feet
Show depth and thickness of all water, oil and gas formations.

OIL, GAS OR WATER RECORDS

CASING RECORD

FORMATION	CONTENT	FROM	TO	SIZE	PUT IN	PULLED OUT
				8-5/8"	217'	-----

Describe in detail the manner in which the well was plugged, indicating where the mud fluid was placed and the method or methods used in introducing it into the hole. If cement or other plugs were used, state the character of same and depth placed, from feet to feet for each plug set.

Mud to 205'
1/3 Sacks Hulls - HOWCO Plug
Plug at 35' - 1/3 Sacks Hulls
10 Sacks Cement

(If additional description is necessary, use BACK of this sheet)

Name of Plugging Contractor Company tools - Stearns Petroleum, Inc.
Address Box 313 - Russell, Kansas

STATE OF KANSAS, COUNTY OF RUSSELL, ss.

(employee of owner) or (owner or operator) of the above-described well, being first duly sworn on oath, says: That I have knowledge of the facts, statements, and matters herein contained and the log of the above-described well as filed and that the same are true and correct. So help me God

(Signature) D. G. Comstock, Prod. Superintendent
Box 313 - Russell, Kansas
(Address)

SUBSCRIBED AND SWORN TO before me this 12th day of March, 19 56

Betty Lou Miller
Notary Public.

My commission expires April 5, 1958

PLUGGING
FILE REC 18 22 R 11W
BOOK PAGE 44 LINE 45

STATE OF KANSAS
3-14-56

GARVIN #1

Operator: Stearns Petroleum, Inc.
 Contractor: Stearns Petroleum, Inc.
 Commencement Date: February 8, 1956
 Completion Date: March 11, 1956
 Elevation: 1819' K.B.
 I. P.: D. & A.

Location:
 NW NW NW
 Section 18-22S-11W
 Stafford County, Kansas

Casing Record:

Ran 10 Joints of 8-5/8" Casing. Set pipe at 217' and cemented with 175 sacks of Pozmix and 2 sacks Calcium Chloride.

WELL LOG

Clay & Sand	0	135
Red Bed	135	564
Anhydrite	564	580
Red Bed & Shale	580	860
Shale & Shells	860	1480
Shale & Lime	1480	1575
Shale, Shells, & Lime	1575	1785
Lime & Shale	1785	2990
Lime	2990	3140
Lime & Shale	3140	3315
Lime	3315	3531
Lime & Chert	3531	3570
Shale, Lime, & Chert	3570	3583
Lime	3583	3695
R.T.D.	3695	


Tops:	Anhydrite	564	(-1255)
	Heebner	3095	(-1276)
	Douglas	3127	
	Brown Lime	3226	(-1407)
	Lansing-Kansas City	3251	(-1432)
	Viola	3527	(-1708)
	Simpson	3552	(-1733)
	Arbuckle	3615	(-1796)
	R. T. D.	3695	(-1876)

STATE OF KANSAS)
) SS:
 COUNTY OF RUSSELL)

I hereby certify that the above information is true and correct to the best of my knowledge.


 O. G. Stearns, President

SUBSCRIBED AND SWORN to before me, a Notary Public on this 12th day of March, 1956.

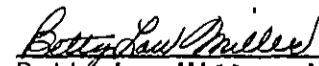
 Betty Lou Miller, Notary Public

My Commission Expires:

April 5, 1958

