

STATE OF KANSAS  
STATE CORPORATION COMMISSION

WELL PLUGGING RECORD  
OR  
FORMATION PLUGGING RECORD

Strike out upper line  
when reporting plug-  
ging of formations.

Give All Information Completely  
Make Required Affidavit  
Mail or Deliver Report to:  
Conservation Division  
State Corporation Commission  
800 Bitting Building  
Wichita, Kansas

Harvey County, Sec. 20 Twp. 22 Rge. (E) 3 (W)

Location as "NE 1/4 NW 1/4 SW 1/4" or footage from lines NW SW

Lease Owner W. C. McBride, Inc.

Lease Name Friesen Well No. 1

Office Address Box # 433, McPherson, Kansas

Character of Well (completed as Oil, Gas or Dry Hole) Oil

Date well completed 6-16-19 32

Application for plugging filed 10-24-19 41

Application for plugging approved 10-25-19 41


Plugging commenced 11-9-19 41

Plugging completed 11-24-19 41

Reason for abandonment of well or producing formation Production declined to such an extent, where it could not be operated.

If a producing well is abandoned, date of last production 10-23-19 41

Was permission obtained from the Conservation Division or its agents before plugging was commenced? Yes

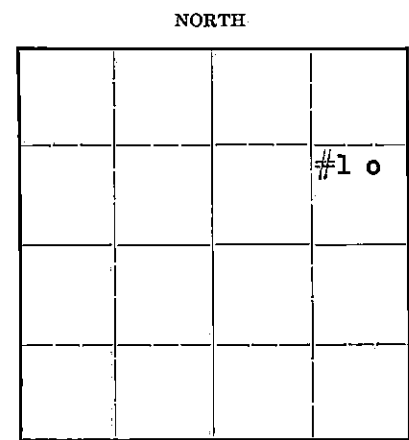

Locate well correctly on above  
Section Plat

Name of Conservation Agent who supervised plugging of this well Rhule Durkee

Producing formation Hunton Lime Depth to top 3503 Bottom 3513 Total Depth of Well 3513 Feet

Show depth and thickness of all water, oil and gas formations.

OIL, GAS OR WATER RECORDS


CASING RECORD

Formation	Content	From	To	Size	Put In	Pulled Out
K. C. Lime	Dry	2504		20"	247' 6"	60'
Chat	Dry	3195		15 1/2"	283'	115'
Hunton Lime	Oil	3503	3513	13 3/8"	1545'	All
				10"	2505'	All
				8 5/8"	3305'	2950'
				7"	3503'	3312'

Describe in detail the manner in which the well was plugged, indicating where the mud fluid was placed and the method or methods used in introducing it into the hole. If cement or other plugs were used, state the character of same and depth placed, from \_\_\_\_\_ feet to \_\_\_\_\_ feet for each plug set.

Six Sacks of cement dumped in hole on bottom, cement dumped with bailer. Plugged with mud from 3500' to 3190' dumped 10 sacks of cement at 3190'. Plugged hole with mud to 200' dumped 30 sacks of cement at 200' filled hole to bottom of cellar and capped hole with 10 sacks of cement in bottom of cellar.

11-28-41

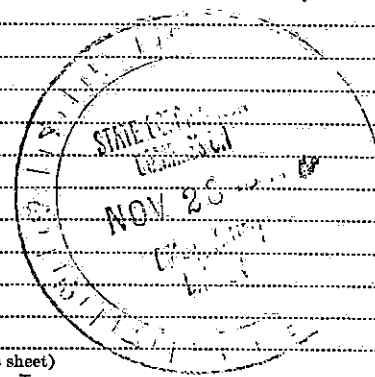

20 22 3W  
12 19

(If additional description is necessary, use BACK of this sheet)

Correspondence regarding this well should be addressed to W. C. McBride, Inc.

Address Box # 433, McPherson, Kansas.

STATE OF KANSAS, COUNTY OF MCPHERSON, ss.

Frank Zimmerman (employee of owner) or (owner or operator) of the above-described well, being first duly sworn on oath, says: That I have knowledge of the facts, statements, and matters herein contained and the log of the above-described well as filed and that the same are true and correct. So help me God.

(Signature) Frank Zimmerman

McPherson Kansas (Address)

SUBSCRIBED AND SWORN to before me this 15th day of December, 1941.

David P. Pohl Notary Public.

My commission expires 7-15-43





Depth from	To	Feet	Formation
	792		Shale
	862		Lime
	870		Shale
	880		R.R.
	895		Lime
	928		Shale
	947		Lime
	951		Shale
	985		Lime
	992		R.R.
	1032		Lime
	1052		Shale
	1090		Lime
	1095		Shale
	1106		Lime
	1145		Shale
	1150		Shale
	1190		Lime
	1202		Shale
	1215		Lime
	1231		Shale
	1252		Lime
	1260		Shale
	1320		Lime
	1400		Shale
	1412		Lime
	1442		Shale
	1450		R.R.
	1580		Shale
	1590		Lime
	1608		Shale
	1628		Lime
	1634		Shale
	1655		Lime
	1665		Shale
	1677		Lime
	1690		Shale
	1702		R.R.
	1726		Lime
	1740		Shale
	1744		Lime
	1790		Shale
	1855		Lime
	1875		Shale
	1890		Lime
	1918		Shale
	1924		Lime
	1929		Shale
	1955		Lime
	2064		Lime
	2093		Shale
	2252		Lime
	2272		Shale
	2278		Lime
	2288		Shale
	2322		Sand
	2339		Shale
	2355		Sand
	2375		Sand
	2390		Lime
	2455		Sand
	2465		Lime
	2504		Shale
	2504		Lime K.C.
	2523		Lime
	2527		Shale
	2538		Lime
	2542		Shale
	2704		Lime
	2718		Shale
	2728		Lime
	2733		Shale
	2754		Lime
	2770		Shale
	2918		Lime
	2924		Shale
	2970		Lime
	2974		R.R.
	3036		Lime
	3057		Shale
	3086		Lime
	3187		Shale
	3248		Chert
	3308		Sand
	3407		Lime
	3500		Shale
	3500		Hunton Lime
	3513		Lime Oil Pay
			Deepened
3513	3519		Lime
	3531		Sylvan Shale

