


STATE OF KANSAS  
STATE CORPORATION COMMISSION

Form CP-4

Give All Information Completely  
Make Required Affidavit  
Mail or Deliver Report to:  
Conservation Division  
State Corporation Commission  
P. O. Box 17027  
Wichita, Kansas 67217  
NORTH

WELL PLUGGING RECORD

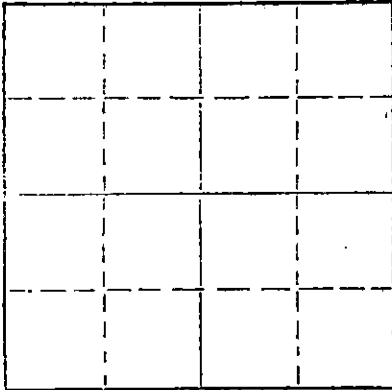

Locate well correctly on above  
Section Plat

Harvey County, Sec. 20 Twp. 22S Rge. 3W (E) (W)X  
Location as "NE/CNW/SW" or footage from lines NE NW NW  
Lease Owner Oil Field Supply & Trading, Inc.  
Lease Name Friesen "C" Well No. No. 2  
Office Address 430 Greenwood, Wichita, Kansas 67211  
Character of Well (completed as Oil, Gas or Dry Hole) D & A  
Date well completed May 7 19 73  
Application for plugging filed May 7 19 73  
Application for plugging approved May 7 19 73  
Plugging commenced May 7 19 73  
Plugging completed May 7 19 73  
Reason for abandonment of well or producing formation D & A

If a producing well is abandoned, date of last production 19  
Was permission obtained from the Conservation Division or its agents before plugging was commenced? YES

Name of Conservation Agent who supervised plugging of this well Hugh E. Scott  
Producing formation Depth to top Bottom Total Depth of Well 3507 Feet  
Show depth and thickness of all water, oil and gas formations.

OIL, GAS OR WATER RECORDS

CASING RECORD

FORMATION	CONTENT	FROM	TO	SIZE	PUT IN	PULLED OUT
				8-5/8"	508'	-0-

Describe in detail the manner in which the well was plugged, indicating where the mud fluid was placed and the method or methods used in introducing it into the hole. If cement or other plugs were used, state the character of same and depth placed, from feet to feet for each plug set.

25 sx cement @ 3000' -  
50 sx @ 480' - 15 sx @ 40'


RECEIVED  
STATE CORPORATION COMMISSION  
JUN 5 1973  
CONSERVATION DIVISION  
Wichita, Kansas

(If additional description is necessary, use BACK of this sheet)

Name of Plugging Contractor Red Tiger Drilling Company  
Address 1720 Wichita Plaza, Wichita, Kansas 67202

STATE OF Kansas COUNTY OF Sedgwick ss.  
Linda Mowrey (employee of owner) or (owner or operator) of the above-described well, being first duly sworn on oath, says: That I have knowledge of the facts, statements, and matters herein contained and the log of the above-described well as filed and that the same are true and correct. So help me God.

(Signature) Linda Mowrey  
1720 Wichita Plaza, Wichita, Kansas 67202  
(Address)

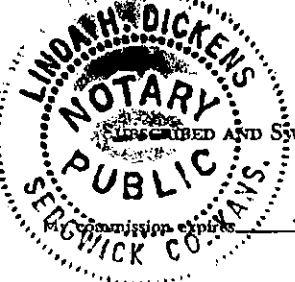

Subscribed and sworn to before me this 30th day of May, 1973

March 8, 1977

Linda H. Dickens

Notary Public.

DRILLERS LOG

No. 2 Friesen "C"

CASING RECORD:	COMPANY: Oil Field Supply & Trading	DESCRIPTION:
8-5/8" @ 508' w/350 sx cement	CONTRACTOR: Red Tiger Drilling Co.	NE NW NW 20-22S-3W Harvey County, Kansas
TOTAL DEPTH: 3507'	COMMENCED: April 28, 1973	COMPLETED: May 7, 1973

ELEVATION:

<u>FORMATION</u>	<u>FROM</u>	<u>TO</u>	<u>REMARKS</u>
Shale & Sand	0	465	
Anhydrite	465	498	
Shale	498	510	
Lime & Shale	510	2570	
Lime	2570	3120	
Shale & Chert	3120	3210	
Chert & Lime	3210	3360	
Chert, Lime & Shale	3360	3420	
Lime	3420	3507	

RECEIVED  
STATE CORPORATION COMMISSION  
JUN 6 1973  
CONSERVATION DIVISION  
Wichita, Kansas

I certify that this is a true and correct copy of the above log to the best of my knowledge.

RED TIGER DRILLING COMPANY

Linda Mowrey  
Linda Mowrey

Subscribed and sworn to before me this 30th day of May, 1973.

Linda H. Dickens  
Notary Public

My Commission Expires:

March 8, 1977

