


STATE OF KANSAS
STATE CORPORATION COMMISSION

WELL PLUGGING RECORD

Give All Information Completely
Make Required Affidavit
Mail or Deliver Report to:
Conservation Division
State Corporation Commission
212 No. Market
Wichita, Kansas

Harvey County, Sec. 9 Twp. 22S Rge. (E) 2W (W)
Location as "NE/CNW/SW" or footage from lines 152' SW C NW SW 9-22-2W
Lease Owner Phillips Petroleum Company
Lease Name Vogt-DB Well No. 1
Office Address Box 287, Great Bend, Kansas 67530
Character of Well (completed as Oil, Gas or Dry Hole) Dry Hole
Date well completed Plugged 12-15-73 19
Application for plugging filed 12-15-73 - Verbal Approval 19
Application for plugging approved 12-15-73 - Verbal Approval 19
Plugging commenced 12-15-73 19
Plugging completed 12-15-73 19
Reason for abandonment of well or producing formation Dry Hole

NORTH

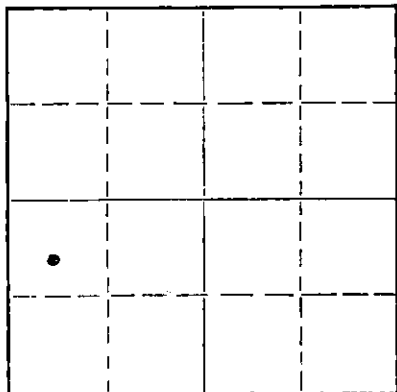

Locate well correctly on above Section Plat

If a producing well is abandoned, date of last production. NA 19
Was permission obtained from the Conservation Division or its agents before plugging was commenced? Yes - Verbal

Name of Conservation Agent who supervised plugging of this well Hugh Scott, Box 924, McPherson, Kansas 67460
Producing formation Mississippi Depth to top 3123' Bottom 3210' Total Depth of Well 3210' Feet
Show depth and thickness of all water, oil and gas formations.

OIL, GAS OR WATER RECORDS

CASING RECORD

FORMATION	CONTENT	FROM	TO	SIZE	PUT IN	PULLED OUT
Mississippi	Dry Hole	3123'	3210'	8-5/8"	257'	None

Describe in detail the manner in which the well was plugged, indicating where the mud fluid was placed and the method or methods used in introducing it into the hole. If cement or other plugs were used, state the character of same and depth placed, from _____ feet to _____ feet for each plug set.

Halliburton spotted 75 sx cmt 3200-2945', filled w/mud to 300', spotted 50 sx cmt 300-175', filled w/mud to 40', Spotted 15 sx cmt 40' to top 8-5/8" csg. Job completed by Halliburton @ 3:30 PM, 12-15-73.

RECEIVED
STATE CORPORATION COMMISSION

DEC 28 1973

CONSERVATION DIVISION
Wichita, Kansas

12-28-73

(If additional description is necessary, use BACK of this sheet)

Name of Plugging Contractor Blackstone Drlg. Company
Address McPherson, Kansas

STATE OF Kansas, COUNTY OF Barton, ss.
C. D. Dohrer (employee of owner) or ~~owner or operator~~ of the above-described well, being first duly sworn on oath, says: That I have knowledge of the facts, statements, and matters herein contained and the log of the above-described well as filed and that the same are true and correct. So help me God.

(Signature) C. D. Dohrer Prod. Supt.
Box 287, Great Bend, Kansas 67530
(Address)

SUBSCRIBED AND SWORN to before me this 19th day of December, 1973

My commission expires 10-27-77

Laura Lee (Parke) Notary Public.



Blackstone Drilling, Inc.

Box 455 • 523 West Kansas • Phone (316) 241-1250

McPHERSON, KANSAS 67460

December 17, 1973

COMPANY: PHILLIPS PETROLEUM COMPANY
 CONTRACTOR: BLACKSTONE DRILLING, INC.
 FARM: VOGT "DB" #1
 LOCATION: NW SW, Sec. 9-²²28-2W, Harvey County, Kansas
 COMMENCED: December 9, 1973
 COMPLETED: December 15, 1973
 ELEVATION: 1464 K. B.

RECEIVED
 STATE CORPORATION COMMISSION
 DEC 28 1973
 CONSERVATION DIVISION
 Wichita, Kansas

0	to	130	Shale & Sand
130	to	170	Shale
170	to	270	Blue Shale
270	to	317	Shale
317	to	690	Shale & Lime
690	to	1023	Lime
1023	to	2140	Shale & Lime
2140	to	2419	Lime & Shale
2419	to	2540	Kansas City
2540	to	2745	Lime
2745	to	2995	Lime & Shale
2995	to	3095	Shale & Lime
3095	to	3123	Shale
3123	to	3210	Mississippi
		3210	T. D.

Cut 12 1/4 inch hole to 257 ft. and run 258.73 ft. of 8 5/8 inch surface pipe, cemented with 175 sacks of portland cement, 2% Gel & 2% C. C., plug down at 2:00 p. m., December 9, 1973. Hole dry and abandoned. Plugged with 75 sacks regular portland at 3200 ft., 50 sacks at 300 ft., and 15 sacks of regular portland at 45 ft. to top of 8 5/8 inch. Job completed by Halliburton at 3:21 p. m., December 15, 1973. Plugging by State Plugger, Hugh Scott, McPherson, Kansas.

TOPS: KANSAS CITY - 2419' MISSISSIPPI - 3123'


Measurements taken from K. B.

CERTIFICATE

I, Charles D. Johnson, Secretary-Treasurer of Blackstone Drilling, Inc. do hereby certify that the above and foregoing is a true and correct copy of log on your Vogt "DB" #1, located NW SW, Sec. 9-228-2W, Harvey County, Kansas as reflected by the files of Blackstone Drilling, Inc.


 Charles D. Johnson - Secretary - Treasurer

Subscribed and sworn to before me a Notary Public in and for McPherson County, Kansas this 17th day of December, 1973.


 Johnnie L. Schmidt - Notary Public



My Commission Expires: June 23, 1977.