


STATE OF KANSAS
STATE CORPORATION COMMISSION

Form CP-4

Give All Information Completely
Make Required Affidavit
Mail or Deliver Report to:
Conservation Division
State Corporation Commission
212 No. Market
Wichita, Kansas 67202

WELL PLUGGING RECORD

NORTH

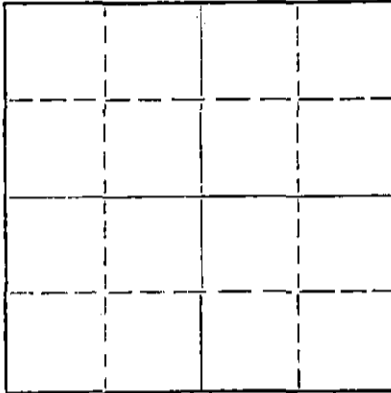

Locate well correctly on above
Section Plat

Stafford County, Sec. 4 Twp. 22S Rge. (E) 14(W)
Location as "NE/CNW/SW" or footage from lines NE-SW-SW
Lease Owner Halliburton Oil Producing Co.
Lease Name Unruh Well No. 2
Office Address 520 Cameron Building, Oklahoma City, Oklahoma
Character of Well (completed as Oil, Gas or Dry Hole) Dry Hole
Date well completed December 20 19 70
Application for plugging filed December 22 19 70
Application for plugging approved 19
Plugging commenced December 20 19 70
Plugging completed same 19
Reason for abandonment of well or producing formation

If a producing well is abandoned, date of last production 19
Was permission obtained from the Conservation Division or its agents before plugging was commenced? yes

Name of Conservation Agent who supervised plugging of this well G. R. Biberstien
Producing formation Depth to top Bottom Total Depth of Well 3875 Feet
Show depth and thickness of all water, oil and gas formations.

OIL, GAS OR WATER RECORDS

CASING RECORD

FORMATION	CONTENT	FROM	TO	SIZE	PUT IN	PULLED OUT

Describe in detail the manner in which the well was plugged, indicating where the mud fluid was placed and the method or methods used in introducing it into the hole. If cement or other plugs were used, state the character of same and depth placed, from feet to feet for each plug set.

Push wood plug to 650' and 40 sacks cement thru drill pipe;
Spot 25 sacks cement at 400' thru drill pipe;
Mud, wood plug and bridge at 40' and 10 sacks cement;
2 sacks cement in rathole.

RECEIVED
STATE CORPORATION COMMISSION
DEC 23 1970
CONSERVATION DIVISION
Wichita, Kansas

12-23-70

(If additional description is necessary, use BACK of this sheet)
Name of Plugging Contractor Aspen Drilling Co.
Address Great Bend, Kansas

STATE OF Kansas, COUNTY OF Barton, ss.
William S. Schachle (employee of owner) or (owner or operator) of the above-described well, being first duly sworn on oath, says: That I have knowledge of the facts, statements, and matters herein contained and the log of the above-described well as filed and that the same are true and correct. So help me God.

(Signature) William S. Schachle
Great Bend, Kansas
(Address)

SUBSCRIBED AND SWORN TO before me this 22nd day of December, 19 70

My commission expires April 18, 1972

Theora Holleman
Theora Holleman Notary Public.

DRILLERS LOG

COMPANY: Halliburton Oil Producing Co.
 CONTRACTOR: Aspen Drilling Co.
 LEASE NAME: Unruh #2
 Location: NE-SW-SW Sec. 4-T22S-R14W
 Stafford County, Kansas

ELEVATION:
 SURFACE CASING: 16 jts. (449') 8 5/8"
 COMMENCED: December 12, 1970
 COMPLETED: December 20, 1970
 ROTARY TOTAL DEPTH: 3875'

<u>FORMATION</u>	<u>DEPTH</u>	
Clay & Sand	200	Ran 16 jts. (449') 8 5/8" casing set at 454' with 375 sacks 60/40 Pozmix. Cement circulated.
Shale & Shells	325	
Sand	400	
Shale & Shells	868	
Anhydrite	890	DST #1 3765-3800
Shale & Shells	1725	DST #2 3830-3975
Shale & Lime	2105	
Lime & Shale	2240	
Shale & Lime	2515	
Lime & Shale	2720	
Shale & Lime	3235	
Lime	3317	
Lime & Shale	3525	
Lime	3875	

D & A RECEIVED
 STATE CORPORATION COMMISSION
 DEC 23 1970
 CONSERVATION DIVISION
 Wichita, Kansas


AFFIDAVIT

State of Kansas)
) ss:
 County of Barton)

The undersigned, being duly sworn on oath, states that the above statement and log are a true and correct record and log of the well drilled at the location above described.


 William S. Schächle, Affiant

Subscribed and sworn to before me this 22nd day of December, 1970.

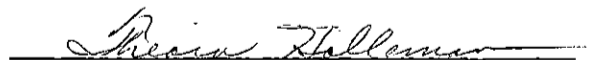
 Theora Holleman, Notary Public

My commission expires: April 18, 1972