


STATE OF KANSAS
STATE CORPORATION COMMISSION

Give All Information Completely
Make Required Affidavit
Mail or Deliver Report to:
Conservation Division
State Corporation Commission
600 Bittling Building
Wichita, Kansas

WELL PLUGGING RECORD

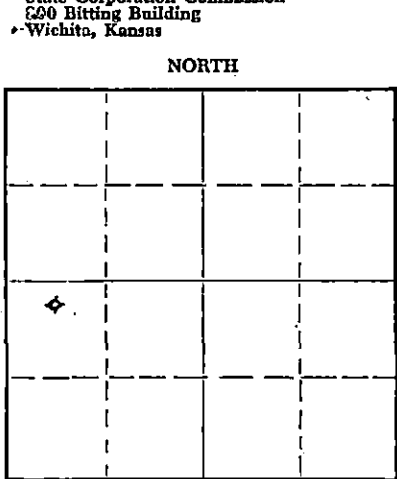

Stafford County, Sec. 2 Twp. 22 Rge. 14 ~~14~~ (W)
Location as "NE/CNW/SW" or footage from lines C N/2 NW SW
Lease Owner Sunray Mid-Continent Oil Company
Lease Name Kenan Well No. 7
Office Address Box 195, Great Bend, Kansas
Character of Well (completed as Oil, Gas or Dry Hole) Dry Hole
Date well completed _____ 19____
Application for plugging filed September 20 19 55
Application for plugging approved September 19 19 55
Plugging commenced September 13 19 55
Plugging completed September 13 19 55
Reason for abandonment of well or producing formation _____

Locate well correctly on above
Section Plat

If a producing well is abandoned, date of last production _____ 19____
Was permission obtained from the Conservation Division or its agents before plugging was commenced? yes

Name of Conservation Agent who supervised plugging of this well M. A. Rives
Producing formation _____ Depth to top _____ Bottom _____ Total Depth of Well 3700 Feet
Show depth and thickness of all water, oil and gas formations.

OIL, GAS OR WATER RECORDS

CASING RECORD

FORMATION	CONTENT	FROM	TO	SIZE	PUT IN	PULLED OUT
				8 5/8	359'	none

Describe in detail the manner in which the well was plugged, indicating where the mud fluid was placed and the method or methods used in introducing it into the hole. If cement or other plugs were used, state the character of same and depth placed, from _____ feet to _____ feet for each plug set.

Mud 3700-300'
Hulls & Halliburton plug at 300'
20 sax cement 300' to 237'
Mud 237' to 35'
Hulls & Halliburton plug 35'
10 sax cement 35' to bottom of cellar
Filled to surface with dirt.

Well log attached.

(If additional description is necessary, use BACK of this sheet)

Name of Plugging Contractor Stickle Drilling Company
Address Tulsa, Oklahoma

STATE OF Kansas, COUNTY OF Barton, ss.
J. F. Dingee, Ass't. Dist Supt. ~~(employee of owner) or (owner or operator)~~ of the above-described well, being first duly sworn on oath, says: That I have knowledge of the facts, statements, and matters herein contained and the log of the above-described well as filed and that the same are true and correct. So help me God.

(Signature) J. F. Dingee
P. O. Box 195, Great Bend, Kansas
(Address)

SUBSCRIBED AND SWORN TO before me this 26th day of September, 19 55

My commission expires December 24, 1956

Notary Public.

PLUGGING
FILE SEC 2 T 22 R 14 W
BOOK PAGE 1 LINE 31

RECEIVED
STATE CORPORATION COMMISSION
SEP 27 1955 9-27-55
CONSERVATION DIVISION
Wichita, Kansas

Sunray Mid-Continent Oil Company
Tulsa, Oklahoma

Tulsa, Oklahoma
September 14, 1955

CONTRACTOR: Stickle Drilling Company
Drilling Commenced: September 3, 1955
Drilling Completed: September 13, 1955

M. Keenan #7 SW/4 Sec. 2-
22S-14W, Stafford County,
Kansas.

DRILLERS LOG

Sand & Shale	0-359
Shale & Shells	359-565
Red Bed	565-835
Anhydrite	835-855
Shale & Shells	855-1410
Sandy Lime & Shale	1410-1585
Lime & Shale	1585-1810
Lime	1810-1965
Sandy Lime & Shale Streaks	1965-2145
Lime & Shale	2145-2155
Shale & Shells	2155-2270
Shale & Lime	2270-2430
Shale & Lime Streaks	2430-2560
Shale & Lime	2560-3125
Lime & Shale	3125-3265
Shale & Lime	3265-3370
Lime & Shale	3370-3574
Lime	3574-3610
Lime & Shale	3610-3648
Lime	3648-3693
Lime & Shale	3693-3700 TD

I, Frank E. Stickle hereby certify the above to be a true and complete Drillers Log of Sunray Mid-Continent Oil Company's M. Keenan #7 SW/4 Section 2-22S-14W, Stafford County, Kansas.

Frank E. Stickle
Frank E. Stickle

Lillian T. Bonham
Notary Public

February 13, 1956
My Commission Expires

RECEIVED
STATE CORPORATION COMMISSION

SEP 27 1955

PLUGGING
FILE SEC 2 T 22 R 14
BOOK PAGE 1 LINE 31

CONSERVATION DIVISION
Wichita, Kansas