

STATE OF KANSAS
STATE CORPORATION COMMISSION

Form CP-4

Give All Information Completely
Make Required Affidavit
Mail or Deliver Report to:
Conservation Division
State Corporation Commission
212 No. Market
Wichita, Kansas

WELL PLUGGING RECORD

Stafford County. Sec. 2 Twp. 22S Rge. (E) 14 (W)

Location as "NE/CNW/SW" or footage from lines SW SW NW

Lease Owner Petroleum, Inc.

Lease Name Strobel #1 (Smallwood Lan-KC Unit #2-1) Well No.

Office Address 352 North Broadway, Wichita, Kansas

Character of Well (completed as Oil, Gas or Dry Hole) oil

Date well completed December 31 1954

Application for plugging filed February 24 1966

Application for plugging approved February 25 1966


Plugging commenced March 9 1966

Plugging completed March 14 1966

Reason for abandonment of well or producing formation depleted

If a producing well is abandoned, date of last production 19

Was permission obtained from the Conservation Division or its agents before plugging was commenced? yes

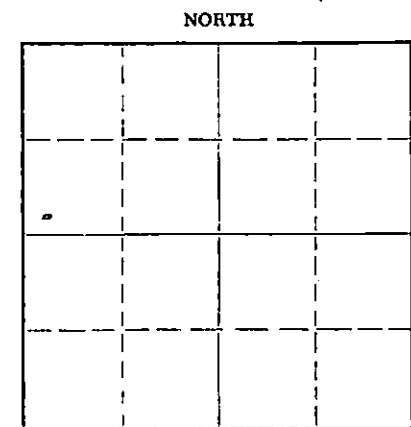

Locate well correctly on above Section Flat

Name of Conservation Agent who supervised plugging of this well Archie Elving

Producing formation _____ Depth to top _____ Bottom _____ Total Depth of Well 3835' Feet

Show depth and thickness of all water, oil and gas formations.

OIL, GAS OR WATER RECORDS

CASING RECORD

FORMATION	CONTENT	FROM	TO	SIZE	PUT IN	PULLED OUT
		0	325'	8 5/8"	325'	none
		0	3680'	5 1/2"	3680'	3022.10

Describe in detail the manner in which the well was plugged, indicating where the mud fluid was placed and the method or methods used in introducing it into the hole. If cement or other plugs were used, state the character of same and depth placed, from _____ feet to _____ feet for each plug set.

Pushed plug to 3537', set 10' rock bridge and dumped 5 sacks of cement at 3527'.

Pushed plug to 200', set 10' rock bridge and dumped 10 gallons of sand.

Mixed 5 sacks of cement with 2% calcium chloride and dumped at 190'.

Bailed hole down and dumped 17 sacks of cement. Filled hole with mud to 40', set 10' rock bridge and capped hole with 10 sacks of cement.

RECEIVED
STATE CORPORATION COMMISSION
WICHITA, KANSAS

MAR 28 1966

CONSERVATION DIVISION
Wichita, Kansas

3-28-66

(If additional description is necessary, use BACK of this sheet)

Name of Plugging Contractor Pipe Pullers, Inc.

Address Box 486, Ellinwood, Kansas

STATE OF Kansas, COUNTY OF Barton, ss. Dean Wells (employee of owner) or (~~owner or operator~~) of the above-described well, being first duly sworn on oath, says: That I have knowledge of the facts, statements, and matters herein contained and the log of the above-described well as filed and that the same are true and correct. So help me God.

(Signature) Dean Wells

Ellinwood, Kansas

(Address)

SUBSCRIBED AND SWORN TO before me this 21 day of March, 1966

[Signature]
Notary Public.

My commission expires July 7, 1968

LOG BUREAU--KANSAS GEOLOGICAL SOCIETY
500 East Murdock, Wichita, Kansas


COPY

Company-ALTMAN PET. CO.
Part- Strobel No. 1
Smallwood L-KC #2-1

SEC. 2 T. 22 R. 14W
SW SW NW

Total Depth 3835'
Comm-11-10-54 Comp. 12-31-54

County Stafford
KANSAS

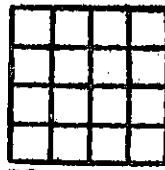

Issue Date 8-20-60

CASING:
8" 342'
5" 3680'

Elevation. 1941' RB

Production. 108 BO.

Figures indicate Bottom of Formations.

COMPLETE DRILLERS LOG NOT AVAILABLE.

TOPS: SCOUT	
Heebner	3304
Brown Lime	3427
Lansing	3439
Marnaton	3686
Conglomerate	3207
Viola	3718
Simpson Lime	3758
Arbuckle	3799

RECEIVED
STATE CORPORATION COMMISSION
MAR 28 1966
CONSERVATION DIVISION
Wichita, Kansas