


STATE OF KANSAS  
STATE CORPORATION COMMISSION

WELL PLUGGING RECORD

Give All Information Completely  
Make Required Affidavit  
Mail or Deliver Report to:  
Conservation Division  
State Corporation Commission  
800 Bitting Building  
Wichita, Kansas

Stafford County. Sec. 1 Twp. 22 Rge. (E) 14 (W)  
Location as "NE/CNW $\frac{1}{4}$ SW $\frac{1}{4}$ " or footage from lines NW NW SE  
Lease Owner Westgate-Greenland Oil Co., et al  
Lease Name Wilson Well No. 1  
Office Address 1009 Central Building, Wichita 2, Kansas  
Character of Well (completed as Oil, Gas or Dry Hole) dry hole  
Date well completed October 22, 1952 19  
Application for plugging filed October 22, 1952 19  
Application for plugging approved October 22, 1952 19  
Plugging commenced October 23, 1952 19  
Plugging completed 5 A.M. October 23, 1952 19  
Reason for abandonment of well or producing formation

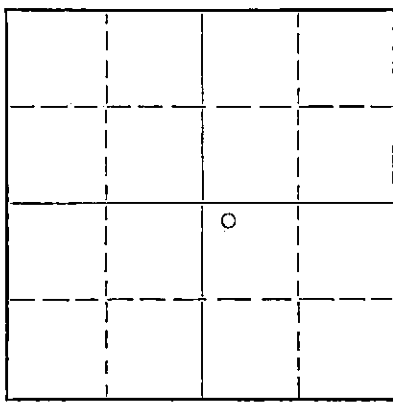

Locate well correctly on above  
Section Plat

If a producing well is abandoned, date of last production 19  
Was permission obtained from the Conservation Division or its agents before plugging was commenced? yes

Name of Conservation Agent who supervised plugging of this well M. A. Rives, Pratt, Kansas  
Producing formation Depth to top Bottom Total Depth of Well Feet  
Show depth and thickness of all water, oil and gas formations.

OIL, GAS OR WATER RECORDS

CASING RECORD

Formation	Content	From	To	Size	Put In	Pulled Out
Surface		0	313	10 3/4"	313	none

Describe in detail the manner in which the well was plugged, indicating where the mud fluid was placed and the method or methods used in introducing it into the hole. If cement or other plugs were used, state the character of same and depth placed, from feet to feet for each plug set.

Filled hole with heavy mud from T. D. 3829 to 300 feet  
Set plug and ran 25 sacks cement from 300 to 250 feet  
Filled with heavy mud from 250 to 25 feet  
Set plug and ran 10 sacks cement to cellar.

(If additional description is necessary, use BACK of this sheet)

Name of Plugging Contractor Westgate Drilling Corporation  
Address 1009 Central Building, Wichita 2, Kansas

STATE OF Kansas, COUNTY OF Sedgwick, ss.  
Harold A. Burt (employee of owner) or (owner or operator) of the above-described well,  
being first duly sworn on oath, says: That I have knowledge of the facts, statements, and matters herein contained and the log of the above-described well as filed and that the same are true and correct. So help me God.

(Signature) Harold A. Burt  
1009 Central Building, Wichita, Ks  
(Address)

SUBSCRIBED AND SWORN to before me this 27th day of October, 1952  
Esther Russell  
Notary Public.

My commission expires May 25, 1953.

23-8390-s 6-51-20M

PLUGGING  
MAX SEC 1 T 22 R 14  
BOOK PAGE 57 LINE 27

RECEIVED  
STATE CORPORATION COMMISSION  
OCT 23 1952 10-28-52  
CONSERVATION DIVISION  
Wichita, Kansas

DRILLER'S LOG

COMPANY: Westgate-Greenland Oil Company  
 CONTRACTOR: Westgate Drilling Corporation  
 FARM: Wilson #1  
 LOCATION: NW NW SE Section 1-22S-14W,  
 Stafford County, Kansas  
 COMMENCED: October 9, 1952  
 COMPLETED: October 23, 1952  
 ELEVATION: 1923 DF

0 to 210 Sand-Clay  
 210 to 280 Shale and sand  
 280 to 313 Shale and shells  
 313 to 785 Red bed and sand  
 785 to 816 Anhydrite  
 816 to 1650 Shale and shells  
 1650 to 1750 Lime and shale  
 1750 to 2065 Lime  
 2065 to 3345 Lime and shale  
 3345 to 3395 Shale  
 3395 to 3645 Lime  
 3645 to 3688 Shale and lime  
 3688 to 3714 Lime  
 3714 to 3747 Lime and chert  
 3747 to 3748 Viola Lime  
 3748 to 3787 Simpson Shale  
 3787 to 3829 Arbuckle lime  
 3829 T. D. (RB)

Set 313 feet of 10 3/4" 32# Surface. Cemented with 225 sacks cement and 2 sacks calcium chloride.

TOPS: Anhydrite 783 Lansing 3404 Simpson 3745  
 Heebner 3268 Base KC 3636 Arbuckle 3784  
 Brown Ls 3392 Viola 3670

Drill Stem Tests:

3403-52, 1 hr, rec. 75' very slightly oil & gas cut mud, 60' gas cut mud, 370# BHP.  
 3466-93, 1 hr, rec. 145' watery mud, 1140# BHP.  
 3561-3598, 1 hr, rec 45' muddy water, 1080# BHP, weak blow for 10 minutes, intermittent blow rest of hour.

Schlumberger run  
 DRY, PLUGGED AND ABANDONED

I, Don Allen, do hereby certify that the above and foregoing is a true and correct copy of the log of the Wilson No. 1, NW NW SE Section 1-22S-14W, Stafford County, Kansas, as reflected by files of the Westgate Drilling Corporation.

*Don Allen*  
 Don Allen

Subscribed and sworn to before me, a Notary Public, within and for Sedgwick County, Kansas, this 24th day of October, 1952.

*Esther Unsell*  
 Esther Unsell, Notary Public

My Commission expires May 25, 1953.

**PLUGGING**  
 FILE 22S-14W-22  
 BOOK PAGE 54 LINE 27