

Compton

15-185.10917-0000

STATE OF KANSAS  
STATE CORPORATION COMMISSION


Form CP-4

WELL PLUGGING RECORD

Give All Information Completely  
Make Required Affidavit  
Mail or Deliver Report to:  
Conservation Division  
State Corporation Commission  
212 No. Market  
Wichita, Kansas

Stafford County, Sec. 1, Twp. 22S, Rge. 14W (E) (W)  
Location as "NE/CNW/SW" or footage from lines 1550 FNL, 330 FEL NE/4

NORTH

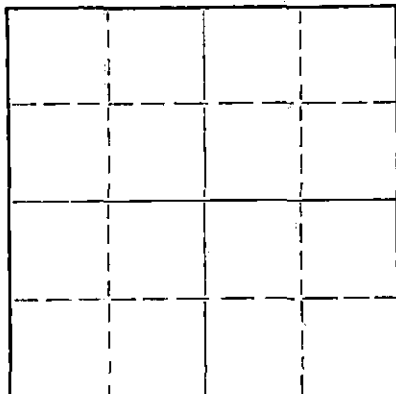

Locate well correctly on above  
Section Plat

Lease Owner Phillips Petroleum  
Lease Name Bordewick Well No. 8  
Office Address Box 287, Gt. Bend, Kan  
Character of Well (completed as Oil, Gas or Dry Hole) oil  
Date well completed 12-22-53 19  
Application for plugging filed 10-14-66 19  
Application for plugging approved 10-17-66 19  
Plugging commenced 10-23-66 19  
Plugging completed 10-28-66 19  
Reason for abandonment of well or producing formation uneconomical

If a producing well is abandoned, date of last production Oct. 1966 19  
Was permission obtained from the Conservation Division or its agents before plugging was commenced? yes

Name of Conservation Agent who supervised plugging of this well A. Elving, Box 248, Pratt, Kan  
Producing formation LKC Depth to top Bottom Record Total Depth of Well 3640 Feet  
Show depth and thickness of all water, oil and gas formations. PTD 3538

OIL, GAS OR WATER RECORDS

CASING RECORD

FORMATION	CONTENT	FROM	TO	SIZE	PUT IN	PULLED OUT
				8-5/8	394	none
				5 1/2	3634	2629'

Describe in detail the manner in which the well was plugged, indicating where the mud fluid was placed and the method or methods used in introducing it into the hole. If cement or other plugs were used, state the character of same and depth placed, from feet to feet for each plug set.

Plugged back with rock from 3538 to 3395. Dumped 7 1/2 sx cement to 3375'.  
Pulled csg. Set rock bridge 340 to 330, ran 5sx cement from 330 to 310;  
Plugged back 310 to 215 with 20 sx cement; mud to 40', 10' rock bridge 40 to 30,  
10 sx cement to surface. Well P&A p.m. 10-28-66.

RECEIVED  
STATE CORPORATION COMMISSION  
NOV 1 1966  
CONSERVATION DIVISION  
Wichita, Kansas  
11-1-66

(If additional description is necessary, use BACK of this sheet)  
Name of Plugging Contractor Knight Casing Pulling Co.  
Address Chase, Kansas

STATE OF Kansas, COUNTY OF Barton, ss.  
M. T. Slagle Dist Supt (employee or owner) or ~~representative~~ of the above-described

well, being first duly sworn on oath, says: That I have knowledge of the facts, statements, and matters herein contained and the log of the above-described well as filed and that the same are true and correct. So help me God.

(Signature) M. T. Slagle  
Box 287, Gt. Bend, Kan  
(Address)

SUBSCRIBED AND SWORN TO before me this 31st day of October, 1966  
Lura Lee Parks  
Notary Public.

My commission expires 10-27-69

EXPLORATION RECORD

1-22S-14W

Lease Bordewick

Well 8

Formation Name	Top	Base	Remarks
Clay sand		40	
Sand		225	
Sand, shalae		398	
Redbed		795	
Anhydrite		824	
Shale and shells		1600	
Lime, shale		1821	
Ft. Riley lime		1950	
Lime shale		2835	
Lime		2932	
Lime, shale		3019	
Lime		3098	
Lime, shale		3182	
Lime		3192	
Lime, shale		3200	
Lime		3312	
Lime, shale		3368	
Lime		3640	

RECEIVED  
 STATE CORPORATION COMMISSION  
 NOV 1 1966  
 CONSERVATION DIVISION  
 Wichita, Kansas