


STATE OF KANSAS
STATE CORPORATION COMMISSION

WELL PLUGGING RECORD

Give All Information Completely
Make Required Affidavit
Mail or Deliver Report to:
Conservation Division
State Corporation Commission
800 Bitting Building
Wichita, Kansas

NORTH

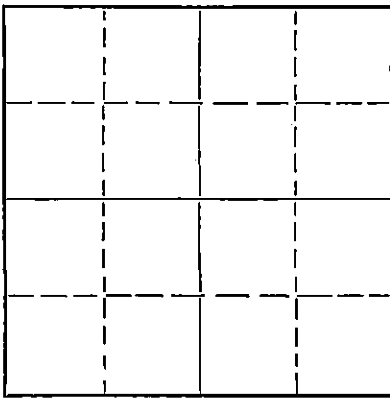

Locate well correctly on above
Section Flat

Stafford County, Sec. 1 Twp. 22 Rge. 14 (E) W (W)
Location as "NE/CNW $\frac{1}{4}$ SW $\frac{1}{4}$ " or footage from lines NE $\frac{1}{4}$ SW $\frac{1}{4}$ NW $\frac{1}{4}$
Lease Owner Republic Natural Gas Company
Lease Name Bordewick Well No. 2
Office Address Box 126, Ellinwood, Kansas
Character of Well (completed as Oil, Gas or Dry Hole) Dry hole
Date well completed January 21 1952
Application for plugging filed January 22 1952
Application for plugging approved Verbal approval from G. D. Stough 1-20-52
Plugging commenced January 21 1952
Plugging completed January 21 1952
Reason for abandonment of well or producing formation Dry hole

If a producing well is abandoned, date of last production 19
Was permission obtained from the Conservation Division or its agents before plugging was commenced? Yes

Name of Conservation Agent who supervised plugging of this well G. D. Stough
Producing formation Arbuckle Depth to top 3779' Bottom Total Depth of Well 3797 Feet
Show depth and thickness of all water, oil and gas formations.

OIL, GAS OR WATER RECORDS

CASING RECORD

Formation	Content	From	To	Size	Put In	Pulled Out
Arbuckle	Dry	3779'	3797'	9-5/8"	275'	None

Describe in detail the manner in which the well was plugged, indicating where the mud fluid was placed and the method or methods used in introducing it into the hole. If cement or other plugs were used, state the character of same and depth placed, from feet to feet for each plug set.

Rotary Mud 3797' to 240'
15 sacks of cement 240' to 195'
Rotary Mud 195' to 30'
10 sacks of cement 30' to surface

1-23-52

(If additional description is necessary, use BACK of this sheet)

Name of Plugging Contractor Gabbert-Jones Drilling Company
Address 507 Orpheum Building, Wichita, Kansas

STATE OF Kansas, COUNTY OF Barton, ss.
Paul Horst (employee of owner) or (owner or operator)

being first duly sworn on oath, says: That I have knowledge of the facts, statements, and matters herein contained and the log of the above-described well as filed and that the same are true and correct. So help me God.

(Signature) Paul Horst


Box 126, Ellinwood, Kansas (Address)

SUBSCRIBED AND SWORN to before me this 22nd day of January, 1952

My commission expires 8-20-55

Yvonne M. Stevenson Notary Public

23-8390-s 6-51-20M

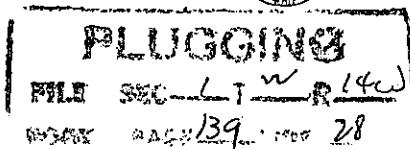

DRILLING LOG

Company: Republic Natural Gas Company
 Well: Bordewick #2
 Location: NE/4 SW/4 NW/4 Section 1-22-14, Stafford County, Kansas
 Contractor: Gabbert-Jones Drilling Company
 Commenced: January 2, 1952
 Completed: January 21, 1952

0 - 200	Sand
200 - 276	Sand shale and shells
276 - 810	Shale, red bed and shells
810 - 840	Anhydrite
840 - 1525	Shale and shells
1525 - 1670	Shale and lime
1670 - 1755	Lime and shale
1755 - 2095	Lime
2095 - 2185	Lime, broken
2185 - 2348	Lime
2348 - 2505	Shale and shells
2505 - 2640	Shale and lime
2640 - 2760	Lime
2760 - 2840	Shale and lime
2840 - 3000	Shale
3000 - 3641	Lime
3641 - 3695	Lime and conglomerate
3695 - 3745	Lime
3745 - 3775	Shale
3775 - 3779	Chert
3779 - 3797	Arbuckle
3797	R.T.D.

PLUGGING
 FILE NO. 1-1-22-14
 139: 28