

STATE OF KANSAS
STATE CORPORATION COMMISSION

Form CP-4

Give All Information Completely
Make Required Affidavit
Mail or Deliver Report to:
Conservation Division
State Corporation Commission
212 No. Market
Wichita, Kansas 67202

WELL PLUGGING RECORD

Stafford County, Sec 1 Twp. 22 Rge. 14 (E) W (W)

Location as "NE/CNW/SE/SW" or footage from lines NW SE SW

Lease Owner E. L. Browning, Pres. Bill Hay Drilling Co., Inc.

Lease Name Wright Well No. # 1

Office Address 2007 Polk ; Great Bend, Kansas 67530

Character of Well (completed as Oil, Gas or Dry Hole)

Date well completed 19

Application for plugging filed December 19 70

Application for plugging approved December 19 70


Plugging commenced January 8 19 71

Plugging completed January 8 19 71

Reason for abandonment of well or producing formation Not economical to operate.
Produced 2 1/2 bbls and over 200 bbls water per day.

If a producing well is abandoned, date of last production 19

Was permission obtained from the Conservation Division or its agents before plugging was commenced? Yes

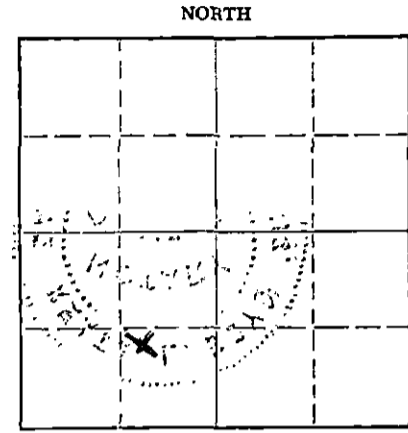

Locate well correctly on above
Section Plat

Name of Conservation Agent who supervised plugging of this well Russell Biberstein

Producing formation Depth to top Bottom Total Depth of Well Feet

Show depth and thickness of all water, oil and gas formations.

OIL, GAS OR WATER RECORDS

CASING RECORD

FORMATION	CONTENT	FROM	TO	SIZE	PUT IN	PULLED OUT
				8 5/8	345	None
				4 1/2	3254	None
RECEIVED STATE CORPORATION COMMISSION JAN 21 1971 CONSERVATION DIVISION Wichita, Kansas						

Describe in detail the manner in which the well was plugged, indicating where the mud fluid was placed and the method or methods used in introducing it into the hole. If cement or other plugs were used, state the character of same and depth placed, from feet to feet for each plug set.

January 8, 1971 Plugged off bottom. Dumped sand to 3300'. Mixed and dumped 4 sx of cement to 3250'.

Plugged off top. Set 20' rock bridge in 4 1/2" casing from 480' to 500'. Mixed and dumped 40 sx of cement from 480' to base of cellar.


4 1/2" casing was cemented in to top of surface.

Name of Plugging Contractor (If additional description is necessary, use BACK of this sheet) RUSS CASING PULLING, INC.
Address P. O. BOX 1082 ; GREAT BEND, KANSAS 67530

STATE OF Kansas, COUNTY OF Barton, ss.
E. L. Browning (employee of owner) or (owner or operator) of the above-described well, being first duly sworn on oath, says: That I have knowledge of the facts, statements, and matters herein contained and the log of the above-described well as filed and that the same are true and correct. So help me God. BILL HAY DRILLING CO., INC.

(Signature) E. L. Browning Pres.
2007 Polk, Great Bend, Kansas 67530 (Address)

Subscribed and sworn to before me this 20th day of January, 19 71

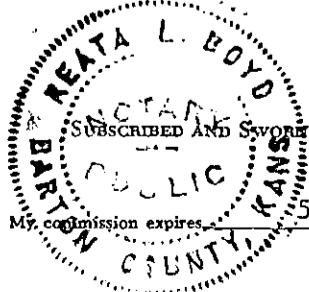

Keata L. Boyd Notary Public.