


STATE OF KANSAS
STATE CORPORATION COMMISSION

WELL PLUGGING RECORD

Give All Information Completely
Make Required Affidavit
Mail or Deliver Report to
Conservation Division
State Corporation Comm.
245 North Water
Wichita, KS 67202

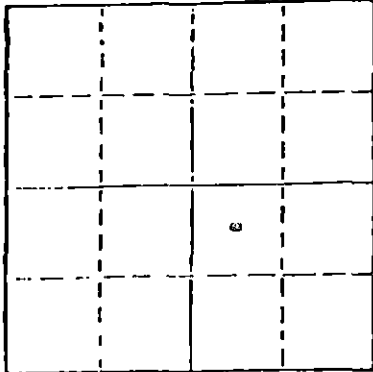

Locate well correctly on above
Section Plat

Hodgeman County, Sec. 21 Twp. 22 Rge. 22 E/W
Location as "NE/CNW $\frac{1}{4}$ SW $\frac{1}{4}$ " or footage from lines
150' N. O. NW SE
Lease Owner Russell F. Freeman
Lease Name Miller Well No. 1
Office Address South Star Route Garden City, Ks.
Character of Well (Completed as Oil, Gas or Dry Hole)

OW/O
Date Well completed September 26 1977
Application for plugging filed 19
Application for plugging approved September 29 1977
Plugging commenced 9 A. M. September 26 1977
Plugging completed September 26 1977
Reason for abandonment of well or producing formation
Unsuccessful work over
If a producing well is abandoned, date of last production 19

Was permission obtained from the Conservation Division or
its agents before plugging was commenced? Yes

Name of Conservation Agent who supervised plugging of this well Dwayne Rankin
Producing formation Depth to top Bottom Total Depth of Well 522
Show depth and thickness of all water, oil and gas formations.

OIL, GAS OR WATER RECORDS

CASING RECORD

FORMATION	CONTENT	FROM	TO	SIZE	PUT IN	PULLED OUT

Describe in detail the manner in which the well was plugged, indicating where the mud fluid
was placed and the method or methods used in introducing it into the hold. If cement or other
plugs were used, state the character of same and depth placed, from 289 feet to
200 feet for each plug set. Ran 9 Jts 2-7/8 tubing. Allied Cementers
cemented with 30 Sk. common with 5% gel thru tubing for a plug 289' to 200'.
Pulled tubing. Pushed an 8-5/8 plug to 30'. Allied cemented thru tubing with
10 Sk. for a plug 30' to 0'. Pulled tubing. Released rig to rig down 11 A.M.

RECEIVED
CORPORATION COMMISSION
2-24-78

(If additional description is necessary, use BACK of this sheet) (OVER)

Name of Plugging Contractor Cheney Well Service & Allied Cementing Co.
Wichita, Kansas


STATE OF Kansas COUNTY OF Finney, ss.
Russell Freeman (employee of owner) or (owner or operator)
of the above-described well, being first duly sworn on oath, says: That I have knowledge of
the facts, statements, and matters herein contained and the log of the above-described well
as filed and that the same are true and correct. So help me God.

(Signature) Russell Freeman
South Star Route Garden City, Ks.
(Address)

SUBSCRIBED AND SWORN TO before me this 22nd day of February, 1978

Norma J. Bates
Notary Public.

My commission expires December 6, 1981

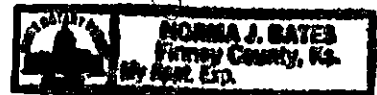

E. Miller #1.

RE*ENTRY OF OLD WELL

Drilled cement plugs 0' to 40' and 170' to 270'. Cleaned out old hole to a point below 400', where an obstruction diverted the bit out of the hole. Drilled to 522'. Suspended operations.

Allied Cementing Service Co. mixed and pumped 30 sacks cement with 5% gel through tubing at 289'. for a plug 289' to 189'. A plug was placed in the 8-5/8 casing at 30'. 10 sacks cement with 5% were mixed and pumped through tubing at 30'. Plug 30' to 0'.

Witnessed by Mr. Dwayne Rankin. Completed September 26, 1977

RECEIVED
STATE CORPORATION COMMISSION

FEB 24 1978

CONSERVATION DIVISION
Wichita, Kansas