


STATE OF KANSAS
STATE CORPORATION COMMISSION

WELL PLUGGING RECORD

Give All Information Completely
Make Required Affidavit
Mail or Deliver Report to:
Conservation Division
State Corporation Commission
800 Bitting Building
Wichita, Kansas

Stafford County, Sec. 23 Twp. 22S Rge. 14W (E) (W)

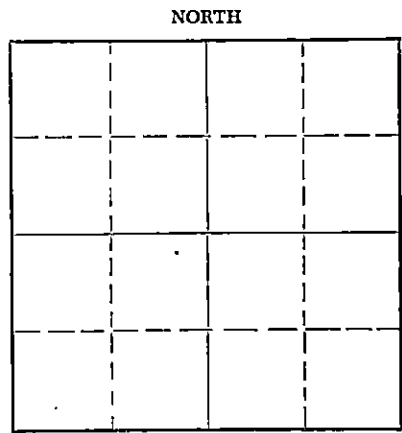

Location as "NE/CNW/SW" or footage from lines SW/4
Lease Owner Lawrence Supply Company
Lease Name Hoffmaster Well No. 1
Office Address Box 448 - Great Bend, Kansas
Character of Well (completed as Oil, Gas or Dry Hole) _____
Date well completed _____ 19____
Application for plugging filed March 30 19 54
Application for plugging approved _____ 19____
Plugging commenced March 29 19 54
Plugging completed April 2 19 54
Reason for abandonment of well or producing formation _____

Locate well correctly on above
Section Plat

If a producing well is abandoned, date of last production _____ 19____
Was permission obtained from the Conservation Division or its agents before plugging was commenced? Yes

Name of Conservation Agent who supervised plugging of this well Merle Rives
Producing formation _____ Depth to top _____ Bottom _____ Total Depth of Well 3700 Feet
Show depth and thickness of all water, oil and gas formations.

OIL, GAS OR WATER RECORDS

CASING RECORD

FORMATION	CONTENT	FROM	TO	SIZE	PUT IN	PULLED OUT
				8-5/8"	240'	None
				5-1/2"	3685'	2716'

Describe in detail the manner in which the well was plugged, indicating where the mud fluid was placed and the method or methods used in introducing it into the hole. If cement or other plugs were used, state the character of same and depth placed, from _____ feet to _____ feet for each plug set.

Filled hole with sand from 3700' to 3620' and ran 5 sacks of cement. Bailed fluid to 240', set a 10' rock bridge at 240' and ran 20 sacks of cement at 230'. Mudded hole to 35', set a 10' rock bridge and ran 10 sacks of cement on top. Plugging completed.

(If additional description is necessary, use BACK of this sheet)

Name of Plugging Contractor West Supply Company
Address Chase, Kansas

STATE OF Kansas COUNTY OF Stafford, ss.
L. B. Lawrence (employee of owner) or (owner or operator) of the above-described well, being first duly sworn on oath, says: That I have knowledge of the facts, statements, and matters herein contained and the log of the above-described well as filed and that the same are true and correct. So help me God. Lawrence Supply Co
(Signature) L. B. Lawrence
Great Bend, Kansas (Address)

SUBSCRIBED AND SWORN TO before me this 28th day of April, 19 54

My commission expires Sept. 15, 1956 Walter J. Volk Notary Public.

24-7968-S 3-53-20M

RECEIVED
STATE CORPORATION COMMISSION

APR 29 1954 4-29-54

CONSERVATION DIVISION
Wichita, Kansas

PLUGGING
FILE SEC 23 TWP 22S R 14W
BOOK PAGE 24 LINE 13


WELL LOG BUREAU—KANSAS GEOLOGICAL SOCIETY
508 East Murdock, Wichita, Kansas

Company- BERWICK DRLG.
Farm- Hoff No. 1

SEC. 23 T. 22 R. 14W
NE NE SW

Total Depth. 3685
Comm. 9-7-51 Comp. 9-16-51
Shot or Treated.
Contractor.
Issued. 12-29-51

County Stafford
KANSAS

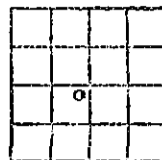

CASING:
8 5/8" 240'
5 1/2" 3685

Elevation. 1931

Production. 686 BO & 3% wtr.

Figures Indicate Bottom of Formations.

no log 240
red rock, shale 1765
shale, lime 2235
shale 2745
shale, lime 3535
lime 3685
Total depth

Scout tops:
Lansing 3466

RECEIVED
STATE CORPORATION COMMISSION
APR 27 1954
CONSERVATION DIVISION
Wichita, Kansas

PLUGGING
FILE SEC 23 T 22 R 14W
BOOK PAGE 24 LINE 13