


STATE OF KANSAS
STATE CORPORATION COMMISSION

WELL PLUGGING RECORD

Give All Information Completely
Make Required Affidavit
Mail or Deliver Report to:
Conservation Division
State Corporation Commission
800 Bittling Building
Wichita, Kansas

NORTH

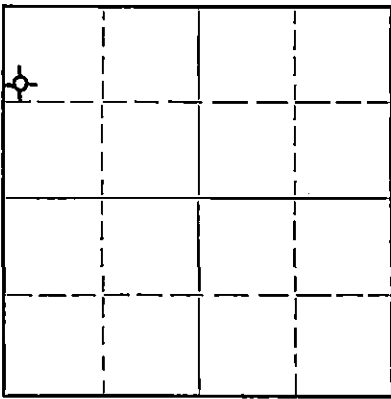

Locate well correctly on above
Section Flat

Stafford County. Sec. 23 Twp. 22S Rge. 14W (XXXX(W))
Location as "NE/CNW $\frac{1}{4}$ /SW $\frac{1}{4}$ " or footage from lines SW NW NW
Lease Owner Imperial Drilling Company, Inc.
Lease Name George Well No. 2
Office Address 903 Union Natl Bank Building, Wichita, Ks.
Character of Well (completed as Oil, Gas or Dry Hole) dry hole
Date well completed December 15, 1953
Application for plugging filed December 16, 1953
Application for plugging approved December 16, 1953
Plugging commenced December 16, 1953
Plugging completed December 16, 1953
Reason for abandonment of well or producing formation no commercial shows
of oil.

If a producing well is abandoned, date of last production 19...
Was permission obtained from the Conservation Division or its agents before plugging was com-
menced? yes

Name of Conservation Agent who supervised plugging of this well M. A. Rives, Box 148, Pratt, Kansas
Producing formation Depth to top Bottom Total Depth of Well 3858 Feet
Show depth and thickness of all water, oil and gas formations.

OIL, GAS OR WATER RECORDS

CASING RECORD

Formation	Content	From	To	Size	Put In	Pulled Out
				8-5/8"	227'	

Describe in detail the manner in which the well was plugged, indicating where the mud fluid was placed and the method or methods used in introducing it into the hole. If cement or other plugs were used, state the character of same and depth placed, from feet to feet for each plug set.

Set #1 plug at 200' with 20
sacks cement. Filled hole
with rotary mud to 40'. Set
#2 plug with 10 sacks cement.

1-7-54

(If additional description is necessary, use BACK of this sheet)

Name of Plugging Contractor Imperial Drilling Company, Inc.
Address 903 Union National Bank Building
Wichita 2, Kansas

STATE OF KANSAS, COUNTY OF SEDGWICK, ss.
Raymond L. Bacon (employee of owner) or (owner or operator) of the above-described well,

being first duly sworn on oath, says: That I have knowledge of the facts, statements, and matters herein contained and the log of the above-described well as filed and that the same are true and correct. So help me God.

(Signature) IMPERIAL DRILLING COMPANY, INC.
By: *Ray L. Bacon* Vice-Pres.
903 Union Natl Bank Bldg.
Wichita 2, Kansas

SUBSCRIBED AND SWORN to before me this 4th day of January, 1954

Marilyn E. Fox
Notary Public.

My commission expires November 9, 1957

23-8390-s 6-51-20M

PLUGGING
FILED SEC 23 T 22 R 14W
BACK PAGE 2 LINE 18

DRILLER'S LOG

Imperial Drilling Company, Inc.
903 Union National Bank Building
Wichita 2, Kansas

George #2 (Hofmaster "B")
SW NW NW Sec. 23-22S-14W
Stafford County, Kansas

Total Depth: 3858'

Elevation: 1927' D.F.
1930' R.B.
Production: D & A

Commenced: 12-4-53 Completed: 12-16-53

Contractor: Imperial Drilling Company, Inc.,
Wichita, Kansas

Casing Record: Set 8-5/8ths" Surface Pipe at 227' W/200 sacks cement.

Figures indicate bottom of formation:

Sand	195'		
Shale and Shells	222'		<u>TOPS</u>
Sand and Shale	560'		
Red Bed and Shale	825'	Anhydrite	825' (/1105')
Anhydrite	855'	Heebner	3312' (-1382')
Shale and Shells	1700'	Brown Limestone	3443' (-1512')
Lime and Shale	2115'	Lansing	3455' (-1525')
Lime	2205'	Conglomerate	3730' (-1800')
Lime and Shale	3445'	Viola	3758' (-1828')
Lime	3858'	Simpson Shale	3782' (-1852')
Total Depth	3858'	Arbuckle	3833' (-1903')
		Total Depth	3858' (-1928')

We hereby certify this to be a correct and accurate log of the above described well as shown on the daily drilling reports.

STATE OF KANSAS IMPERIAL DRILLING COMPANY, INC.

JAN 7 - 1954

CONCORDIA COUNTY DIVISION
Wichita, Kansas

By: Raymond L. Bacon Vice-Pres.
Raymond L. Bacon

Subscribed and sworn to before me this 4th day of January, 1954.

Marjorie E. Jop
Notary Public

My Commission Expires: November 9, 1957

PLUGGING
FILE SEC 23 T 22 R 14W
BOOK PAGE 2 LINE 18


WELL LOG BUREAU--KANSAS GEOLOGICAL SOCIETY
508 East Murdock, Wichita, Kansas

Company- IMPERIAL DRILLING COMPANY, INC.
Farm- George (Hofmaster No. 2
"B")

SEC. 23 T. 22 R. 11W
SW NW NW

Total Depth. 3858
Comm. 12-14-53 Comp. 12-16-53
Shot or Treated.
Contractor. Imperial Drlg. Co., Inc.
Issued. 3-13-54

County Stafford
KANSAS

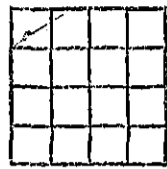

CASING:
8 5/8" 227' cem. w/200 sx

Elevation. 1927 DF

Production. Dry

Figures Indicate Bottom of Formations.

sand	195
shale & shells	222
sand & shale	560
red bed & shale	825
anhydrite	855
shale & shells	1700
lime & shale	2115
lime	2205
lime & shale	3445
lime	3858
Total Depth	

Tops:	
Anhydrite	825
Heebner	3312
Brown Limestone	3443
Lansing	3455
Conglomerate	3730
Viola	3758
Simpson Shale	3782
Arbuckle	3833

DST: 3568-88' weak flow
7 min. open 1 hr. BHP 20 min.
DST: 3605-25' open 1 hr. weak
blow 20 min. rec. 25' mud.
BHP 520#. 20 min.
DST: 3759-3777' using 18'
anchor, open 1 hr. light blow
for 20 mins. rec. 15' mud.
20 mins. shut in BHP 25#.

RECEIVED
STATE CORPORATION COMMISSION
APR 29 1954
CONSERVATION DIVISION
Wichita, Kansas

PLUGGING
FILE SEC 23 T 22 R 14W
BOOK PAGE 24 LINE 12