

STATE OF KANSAS
STATE CORPORATION COMMISSION


Form CP-4

WELL PLUGGING RECORD

Give All Information Completely
Make Required Affidavit
Mail or Deliver Report to:
Conservation Division
State Corporation Commission
212 No. Market
Wichita, Kansas

Stafford County. Sec. 23 Twp. 22 Rge. (E) 14 (W)
Location as "NE/CNW/SW" or footage from lines SE SE SW
Lease Owner Woodman & Iannitti Drlg. Co.
Lease Name Hofmaster Well No. 2
Office Address 706 Union Nat'l. Bldg.
Character of Well (completed as Oil, Gas or Dry Hole) Dry
Date well completed June 2 19 69
Application for plugging filed June 2 19 69
Application for plugging approved June 2 19 69
Plugging commenced June 2 19 69
Plugging completed June 2 19 69
Reason for abandonment of well or producing formation Dry

NORTH

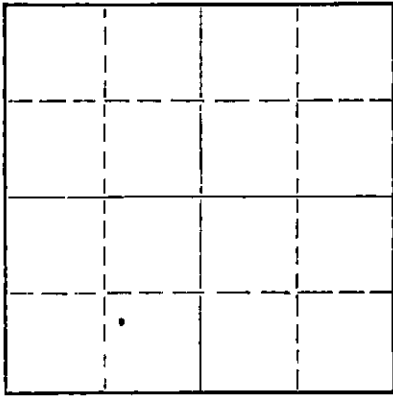

Locate well correctly on above
Section Plat

If a producing well is abandoned, date of last production _____ 19____
Was permission obtained from the Conservation Division or its agents before plugging was commenced? Yes

Name of Conservation Agent who supervised plugging of this well Ralph J. Warren
Producing formation _____ Depth to top _____ Bottom _____ Total Depth of Well 3938 Feet
Show depth and thickness of all water, oil and gas formations.

OIL, GAS OR WATER RECORDS

CASING RECORD

FORMATION	CONTENT	FROM	TO	SIZE	PUT IN	PULLED OUT
				8 5/8	275'	

Describe in detail the manner in which the well was plugged, indicating where the mud fluid was placed and the method or methods used in introducing it into the hole. If cement or other plugs were used, state the character of same and depth placed, from _____ feet to _____ feet for each plug set.

Bottom plug 450' w/50 sx
Middle plug 250' w/25 sx
Top plug 40' w/10 sx

RECEIVED
STATE CORPORATION COMMISSION
JUN 4 1969
CONSERVATION DIVISION
Wichita, Kansas

(If additional description is necessary, use BACK of this sheet)

Name of Plugging Contractor Woodman & Iannitti Drilling Company
Address 706 Union National Bldg.

STATE OF KANSAS, COUNTY OF SEDGWICK, ss.
K. T. WOODMAN (employee of owner) or (owner or operator) of the above-described well, being first duly sworn on oath, says: That I have knowledge of the facts, statements, and matters herein contained and the log of the above-described well as filed and that the same are true and correct. So help me God.

(Signature) K. T. Woodman
706 Union National Bldg.
(Address)

SUBSCRIBED AND SWORN to before me this 3rd day of June, 19 69

My commission expires Feb. 11, 1972
Justina Chamberlain
Notary Public.



KANSAS GEOLOGICAL SOCIETY
KANSAS WELL LOG BUREAU - KANSAS WELL SAMPLE BUREAU
KANSAS GEOLOGICAL SOCIETY BUILDING
508 EAST MURDOCK - WICHITA, KANSAS

COMPANY Woodman & Iannitti Drilling Co.

SEC. 23 T. 22 R. 14W


FARM Hofmaster NO. 2

LOC. SE SE SW

TOTAL DEPTH 3938'
COMM. May 26, 1969 COMP. June 2, 1969

COUNTY Stafford
KANSAS

SHOT OR TREATED
CONTRACTOR Woodman & Iannitti Drilling Co.
ISSUED

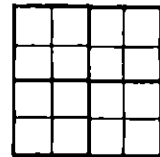

CASING
20 10
15 8 5/8 @ 275 w/200 sx
12 6
13 5

ELEVATION 1934 K.B.

PRODUCTION

FIGURES INDICATE BOTTOM OF FORMATIONS

240	Sand
275	Shale
360	Shale & Sand
823	Red Bed
870	Anhy
950	Shale
1665	Red Bed & Shale
1920	Shale & Lime
2120	Lime & Shale
2260	Lime
2430	Lime & Shale
2690	Lime & Shale
2805	Lime & Shale
2935	Lime & Shale
3090	Lime & Shale
3210	Lime & Shale
3315	Lime & Shale
3455	Lime
3531	Lime
3630	Lime
3655	Lime
3750	Lime
3855	Lime & Shale
3938	Viola

RECEIVED
STATE CORPORATION COMMISSION
JUN 4 1969
CONSERVATION DIVISION
Wichita, Kansas

I certify the above to be a true and correct copy of the driller's log to the best of my knowledge and belief.

Woodman & Iannitti Drilling Co.

K. T. Woodman
K. T. Woodman