


STATE OF KANSAS  
STATE CORPORATION COMMISSION

WELL PLUGGING RECORD

Give All Information Completely  
Make Required Affidavit  
Mail or Deliver Report to:  
Conservation Division  
State Corporation Commission  
211 N. Broadway  
Wichita, Kansas

Stafford County, Sec. 4 Twp. 22 Rge. 14 (E, W, (W))  
Location as "NE/CNW/SW" or footage from lines SESESE  
Lease Owner Nadel and Gussman  
Lease Name Adams Well No. 1  
Office Address \_\_\_\_\_  
Character of Well (completed as Oil, Gas or Dry Hole) \_\_\_\_\_  
Date well completed 1-12-56  
Application for plugging filed 1-12-56  
Application for plugging approved 1-12-56  
Plugging commenced 1-12-56  
Plugging completed 1-12-56  
Reason for abandonment of well or producing formation Dry

NORTH

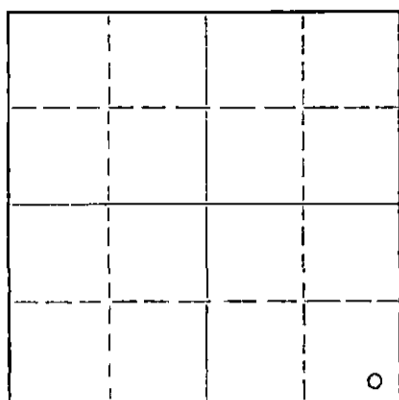

Locate well correctly on above  
Section Plat

If a producing well is abandoned, date of last production \_\_\_\_\_ 19\_\_\_\_  
Was permission obtained from the Conservation Division or its agents before plugging was commenced? \_\_\_\_\_

Name of Conservation Agent who supervised plugging of this well \_\_\_\_\_  
Producing formation \_\_\_\_\_ Depth to top \_\_\_\_\_ Bottom \_\_\_\_\_ Total Depth of Well 3875 Feet  
Show depth and thickness of all water, oil and gas formations.

OIL, GAS OR WATER RECORDS

CASING RECORD

FORMATION	CONTENT	FROM	TO	SIZE	PUT IN	PULLED OUT
				8-5/8"	240	0

Describe in detail the manner in which the well was plugged, indicating where the mud fluid was placed and the method or methods used in introducing it into the hole. If cement or other plugs were used, state the character of same and depth placed, from \_\_\_\_\_ feet to \_\_\_\_\_ feet for each plug set.

Filled hole with heavy mud from T.D. to 260' - set plug with 20 sacks of cement - set top plug at 35' with 10 sacks cement

1-17-56

(If additional description is necessary, use BACK of this sheet)  
Name of Plugging Contractor Reserve Drilling Company, Inc.  
Address Wichita, Kansas

STATE OF KANSAS, COUNTY OF SEDGWICK, ss.  
L. C. Hay (employee of owner) ~~BY HIS OWN HAND~~

well, being first duly sworn on oath, says: That I have knowledge of the facts, statements, and matters herein contained and the log of the above-described well as filed and that the same are true and correct. So help me God.


(Signature) R. C. Hay

Wichita, Kansas  
(Address)

SUBSCRIBED AND SWORN TO before me this 13th day of January, 1956

Nola Babb  
Notary Public.

My commission expires 11-3-56

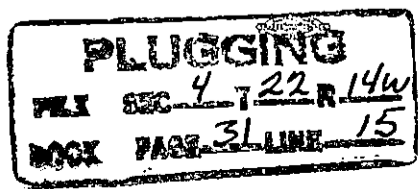

WELL LOG

Nadel and Gussman

ADAMS No. 1

SE SE SE 4-22-14W  
Stafford County, Kansas

Comm: 12-31-55  
Comp: 1-12-56

Casing: 8-5/8" 241' w/175 sax

Formations

Depth

Geological Tops

Sand	125		
Iron	135	Heebner Shale	3328
Shale	243	Brown Lime	3451
Shale and sand	370	Lansing-Kansas City	3461
Shale and red bed	853	B. Kansas City	3683
Anhydrite	880	Viola	3744
Shale and shells	1620	Simpson Shale	3777
Shale and lime	3050	Simpson Sand	3798
Lime	3300	Arbuckle	3824
Lime and shale	3500		
Lime	3875		

STATE OF KANSAS )  
COUNTY OF SEDGWICK ) SS:

L. C. Hay, of lawful age, deposes and states that the above formations and depths are correct as shown by the daily drilling log of the Adams No. 1 in the SE SE SE 4-22-14W, Stafford County, Kansas.

*L. C. Hay*  
L. C. Hay

Subscribed and sworn to before me this 13th day of January, 1956.

*Nola Babb*  
Nola Babb, Notary Public

My commission expires Nov. 3, 1956

**PLUGGING**  
WELL SEC 4 T 22 R 14W  
BOOK PAGE 31 LINE 15