


STATE OF KANSAS
STATE CORPORATION COMMISSION

WELL PLUGGING RECORD

Give All Information Completely
Make Required Affidavit
Mail or Deliver Report to:
Conservation Division
State Corporation Commission
800 Bittling Building
Wichita, Kansas

Stafford County. Sec. 4 Twp. 22S Rge. 14 (W)

Location as "NE/CNW/SW" or footage from lines 990 fr. E, 330 fr. N, NE/4
Lease Owner Phillips Petroleum Company
Lease Name Gartung Well No. 1
Office Address Box 779, Great Bend, Kansas
Character of Well (completed as Oil, Gas or Dry Hole) Dry Hole
Date well completed August 19 19 55
Application for plugging filed August 19 19 55
Application for plugging approved August 22 19 55
Plugging commenced August 19 19 55
Plugging completed August 20 19 55
Reason for abandonment of well or producing formation Dry Hole

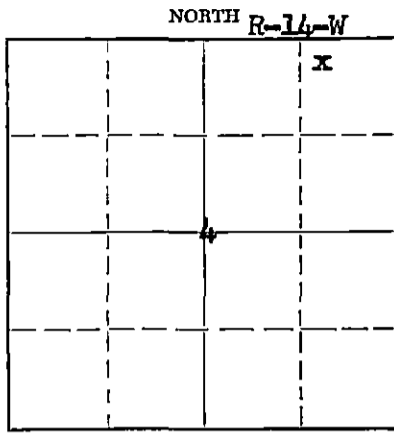

Locate well correctly on above
Section Plat

If a producing well is abandoned, date of last production - 19 -
Was permission obtained from the Conservation Division or its agents before plugging was commenced? Yes

Name of Conservation Agent who supervised plugging of this well Warren H. Horner
Producing formation Arbuckle Depth to top 3806 Bottom 3860 Total Depth of Well 3860 Feet
Show depth and thickness of all water, oil and gas formations.

OIL, GAS OR WATER RECORDS

CASING RECORD

FORMATION	CONTENT	FROM	TO	SIZE	PUT IN	PULLED OUT
Heebner	Dry	3304	3326	9-5/8"	414.75 OA	None
Toronto	Dry	3326	3344			
Douglas	Dry	3344	3423			
Brown Limestone	Dry	3423	3433			
Lansing-Kansas City	Dry	3433	3664			
Viola	Dry	3718	3758			
Simpson	Dry	3758	3806			
Arbuckle	Dry	3806	3860			

Describe in detail the manner in which the well was plugged, indicating where the mud fluid was placed and the method or methods used in introducing it into the hole. If cement or other plugs were used, state the character of same and depth placed, from _____ feet to _____ feet for each plug set.

Mudded hole with heavy mud from 3860 to 300'. Pushed Halliburton wood plug to 300'. Dumped 35 sx. Pozmix cement in filling to 220'. Mudded hole 220' to 35'. Pushed wood plug to 35'. Dumped 1/2 sack hulls on plug and dumped 15 sx. cement in filling to base of cellar. Well plugged and abandoned at 12:30 A.M. 8-20-55.

RECEIVED
STATE CORPORATION COMMISSION
AUG 26 1955
CONSERVATION DIVISION
Wichita, Kansas

(If additional description is necessary, use BACK of this sheet)

Name of Plugging Contractor Sterling Drilling Company
Address Sterling, Kansas

STATE OF Kansas, COUNTY OF Barton, ss.
A. J. Willis (employee of owner ~~not to be used~~ of the above-described

well, being first duly sworn on oath, says: That I have knowledge of the facts, statements, and matters herein contained and the log of the above-described well as filed and that the same are true and correct. So help me God.

(Signature) A. J. Willis

Box 779, Great Bend, Kansas
(Address)

SUBSCRIBED AND SWORN TO before me this 24th day of August, 19 55

My commission expires November 18, 1957

Joseph M. Beal
Notary Public.

PLUGGING
FILE SEC 4 T 22 R 14 W
BOOK PAGE 144 LINE 11

EXPLORATION RECORD

PHILLIPS PETROLEUM COMPANY - WELL LOG

Lease Cartang (990 from E, 330 fr. North, NE/4 Sec.4-22S-14W Well 1

Stafford County, Kans.

Formation Name	Top	Base	Remarks
Sand	0	200	
Shale and shells	200	275	
Sand and clay	275	380	
Redbed and clay	380	425	
Redbed and shale	425	850	
Anhydrite	850	875	
Redbed and shale	875	900	
Redbed, shale and shells	900	1550	
Lime and shale	1550	1935	
Lime	1935	2215	
Lime and shale	2215	3240	
Lime	3240	3290	
Lime and shale	3290	3485	
Lime	3485	3625	**Drill Stem Tested
Lime and shale	3625	3666	
Lime and shale	3666	3727	
Lime	3727	3760	
Lime and shale	3760	3795	**Drill Stem Tested
Sand and shale	3795	3809	
Lime	3809	3860	
			*Not penetrated at 3860' TD.
			**See Daily Report Detailed.

FORMATION TOPS: (Electric Log Tops)

Heebner	3304
Toronto	3326
Douglas	3344
Brown Limestone	3423
Lansing-Kansas City	3433
Base LKC	3664
Viola	3718
Simpson	3758
Arbuckle	3806
TD	3860

PLUGGING
 FILE SEC 4 T 22 R 14 W
 BOOK PAGE 144 LINE 11

RECEIVED
 STATE CORPORATION COMMISSION
 AUG 26 1955
 CONSERVATION DIVISION