


Give All Information Completely  
Make Required Affidavit  
Mail or Deliver Report to:  
Conservation Division  
State Corporation Commission  
211 No. Broadway  
Wichita, Kansas

WELL PLUGGING RECORD

Stafford County, Sec. 4 Twp. 22S Rge. 14W (E) (W)

Location as "NE/CNW/SW" or footage from lines NW NW SW  
Lease Owner Halliburton Oil Producing Co.  
Lease Name Unruh Well No. 3  
Office Address 2915 Classen Blvd., Oklahoma City, Okla.  
Character of Well (completed as Oil, Gas or Dry Hole) Dry Hole  
Date well completed February 8 1971  
Application for plugging filed February 8 1971  
Application for plugging approved February 8 1971  
Plugging commenced February 8 1971  
Plugging completed February 8 1971  
Reason for abandonment of well or producing formation Dry Hole

NORTH

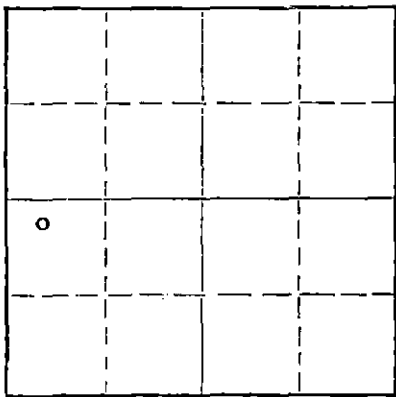

Locate well correctly on above Section Plat

If a producing well is abandoned, date of last production 19  
Was permission obtained from the Conservation Division or its agents before plugging was commenced? Yes

Name of Conservation Agent who supervised plugging of this well G. R. Biberstein, Attila, Kansas  
Producing formation \_\_\_\_\_ Depth to top \_\_\_\_\_ Bottom \_\_\_\_\_ Total Depth of Well 3898 Feet  
Show depth and thickness of all water, oil and gas formations.

OIL, GAS OR WATER RECORDS

CASING RECORD

FORMATION	CONTENT	FROM	TO	SIZE	PUT IN	PULLED OUT
		0	510'	8 5/8"	510'	None

Describe in detail the manner in which the well was plugged, indicating where the mud fluid was placed and the method or methods used in introducing it into the hole. If cement or other plugs were used, state the character of same and depth placed, from \_\_\_\_\_ feet to \_\_\_\_\_ feet for each plug set.

Plug: 800'/40 sacks cement  
450'/30 sacks cement  
40'/10 sacks cement


RECEIVED  
STATE CORPORATION COMMISSION  
FEB 12 1971  
CONSERVATION DIVISION  
Wichita, Kansas

(If additional description is necessary, use BACK of this sheet)

Name of Plugging Contractor Hellar Drilling Company, Inc.  
Address 339 Union Center Bldg., Wichita, Kansas 67202

STATE OF Kansas, COUNTY OF Sedgwick, ss.  
D. L. Hellar, President of Hellar Drlg. Co., Inc. (employee of owner) or (owner or operator) of the above-described well, being first duly sworn on oath, says: That I have knowledge of the facts, statements, and matters herein contained and the log of the above-described well as filed and that the same are true and correct. So help me God.

(Signature) D. L. Hellar D. L. Hellar, President  
339 Union Center Bldg., Wichita, Kansas 67202  
(Address)

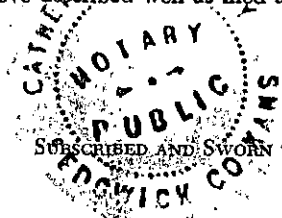

SUBSCRIBED AND SWORN to before me this 11th day of February, 1971

Catherine Darcey  
Catherine Darcey - Notary Public.

My commission expires March 25, 1972

DRILLER'S LOG

COMPANY: Halliburton Oil Producing Co., 2915 Classen Blvd.  
 Oklahoma City, Okla. 73106  
 CONTRACTOR: Hellar Drilling Company, Inc., Wichita, Kansas 67202  
 LEASE: #3 Unruh  
 LOCATION: NW NW SW 4-22S-14W, Stafford County, Kansas  
 COMMENCED: January 26, 1971  
 COMPLETED: February 8, 1971  
 CASING: Set 8 5/8" Surface Casing @ 510'/375 sacks cement

0-529	Shale & Sand
529-800	Red Bed
800-1765	Red Bed & Salt & Lime Streaks
1765-2355	Lime & Shale
2355-2467	Shale & Lime
2467-2516	Shale
2516-2610	Lime & Shale
2610-2845	Shale & Lime
2845-3145	Topeka Lime & Shale
3145-3410	Lime & Shale
3410-3446	Shale
3446-3820	Lime
3820-3898	Lime & Shale
3898	Rotary Total Depth

RECEIVED  
 STATE CORPORATION COMMISSION  
 FEB 12 1971  
 CONSERVATION DIVISION  
 Wichita, Kansas

D & A

STATE OF KANSAS )  
 ) SS  
 COUNTY OF SEDGWICK )

I, D. L. Hellar, do hereby certify that the above and foregoing is a true and correct copy of the log of the #3 Unruh, located in NW NW SW 4-22S-14W, Stafford County, Kansas, as reflected by the files of the Hellar Drilling Company, Inc.

HELLAR DRILLING COMPANY, INC.

By *D. L. Hellar*  
 President - D. L. Hellar

Subscribed and sworn to before me, a Notary Public, in and for sedgwick County, Kansas, this 11th day of February, 1971.



*Catherine Darcey*  
 Notary Public - Catherine Darcey

My Commission Expires:  
 March 25, 1972.