


STATE OF KANSAS
STATE CORPORATION COMMISSION

Form CP-4

Give All Information Completely
Make Required Affidavit
Mail or Deliver Report to:
Conservation Division
State Corporation Commission

WELL PLUGGING RECORD

P. O. Box 17027
Wichita, Kansas 67217
NORTH

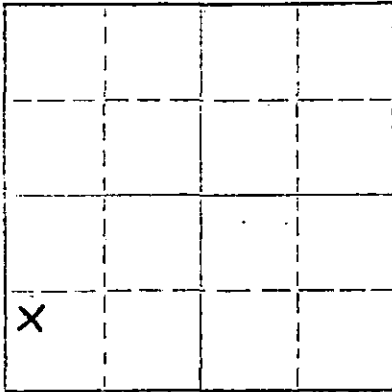

Locate well correctly on above
Section Plat

Stafford County. Sec. 4 Twp. 22 Rge. 14 (E) W (W)
Location as "NE/CNWSW" or footage from lines NW SW SW
Lease Owner Halliburton Oil Production Co.
Lease Name Unruh Well No. #1
Office Address Cameron Bldg. 2915 Classen Blvd.; Okla. City, Okla
Character of Well (completed as Oil, Gas or Dry Hole) Oil
Date well completed 12-10 19 70
Application for plugging filed September 1973
Application for plugging approved September 1973
Plugging commenced September 14 1973
Plugging completed October 16 1973
Reason for abandonment of well or producing formation Depleted
If a producing well is abandoned, date of last production 6-14 1973
Was permission obtained from the Conservation Division or its agents before plugging was commenced? Yes

Name of Conservation Agent who supervised plugging of this well Russell Biberstein
Producing formation Arbuckle Depth to top 3848 Bottom 3867 Total Depth of Well 3867 Feet
Show depth and thickness of all water, oil and gas formations.

OIL, GAS OR WATER RECORDS

CASING RECORD

FORMATION	CONTENT	FROM	TO	SIZE	PUT IN	PULLED OUT
Arbuckle	Oil & Water	3848	3867	8 5/8" 4 1/2"	382 3850	None 2710

RECEIVED
STATE CORPORATION COMMISSION
NOV 6 1973
CONSERVATION DIVISION
Wichita, Kansas

Describe in detail the manner in which the well was plugged, indicating where the mud fluid was placed and the method or methods used in introducing it into the hole. If cement or other plugs were used, state the character of same and depth placed, from _____ feet to _____ feet for each plug set.

September 14, 1973 Plugged off bottom. Dumped sand to 3400'.
Mixed and dumped 4 sx of cement.
October 16, 1973 Plugged off top. Allied Cementing Co. mixed
and pumped down 8 5/8" surface casing, 2 sx
of hulls, 10 sx of gel, released plug and
100 sx plus 4% gel cement.

(If additional description is necessary, use BACK of this sheet)
Name of Plugging Contractor RUSS CASING PULLING, INC.
Address P. O. Box 1082 ; Great Bend, Kansas 67530

STATE OF Oklahoma COUNTY OF Oklahoma, ss.
D. D. Swearingen (employee of owner) or (owner or operator) of the above-described
well, being first duly sworn on oath, says: That I have knowledge of the facts, statements, and matters herein contained and the log of the
above-described well as filed and that the same are true and correct. So help me God.
(Signature) D. D. Swearingen, Superintendent
Cameron Bldg., 2915 Classen Blvd. Okla. City, Okla.
(Address)

SUBSCRIBED AND SWORN to before me this 5th day of November, 19 73
Leba A. Oldfield
Notary Public.
My commission expires 1-17-73

Unruh #1
NW SW SW
Sec. 4, Twp. 22S, Rge. 14W
Stafford County, Kansas
Gartung Pool

Heebner	3336
Brown Lime	3458
Lansing	3466
Viola	3773
Simpson	3798
Arbuckle	3848
TD	3858

8-5/8" Set @ 382° 325 Sx
4-1/2" Set @ 3850° 150 Sx

Well drilled by Halliburton November, 1970

*1/8 E
N
loc. N
Radium on K-19
CORNER*

*1/8 E
N SIDE*

RECEIVED
STATE CORPORATION COMMISSION

SEP 18 1973

CONSERVATION DIVISION
Wichita, Kansas