

SIDE ONE

STATE CORPORATION COMMISSION OF KANSAS
OIL & GAS CONSERVATION DIVISION
WELL COMPLETION FORM
ACO-1 WELL HISTORY
DESCRIPTION OF WELL AND LEASE


Operator: License # 5663
Name: Hess Oil Company
Address P.O. Box 1009
City/State/Zip McPherson, KS 67460
Purchaser: Clear Creek, Inc.
Operator Contact Person: James H. Hess
Phone (316) 241-4640
Contractor: Name: Mallard JV, Inc.
License: 4958

Wellsite Geologist: James C. Hess
Designate Type of Completion
 New Well Re-Entry Workover
 Oil SWD Temp. Abd.
 Gas Inj Delayed Comp.
 Dry Other (Core, Water Supply, etc.)

If DWIO: old well info as follows:
Operator: _____
Well Name: _____
Comp. Date _____ Old Total Depth _____
Drilling Method:
 Mud Rotary Air Rotary Cable
8-15-89 8-22-89 9-29-89
Spud Date Date Reached TD Completion Date

API NO. 15- 185-22,599-0000
County Stafford
E/2 SE NE Sec. 12 Twp. 22 Rge. 13 East West
3300 Ft. North from Southeast Corner of Section
330 Ft. West from Southeast Corner of Section
(NOTE: Locate well in section plat below.)
Lease Name Teichmann "A" Well # 2
Field Name Branch
Producing Formation Arbuckle
Elevation: Ground 1882' KB 1890'
Total Depth 3685' PBD _____

RECEIVED
STATE CORPORATION COMMISSION
JAN 3 1990
1-3-90
CONSERVATION DIVISION
Wichita, Kansas

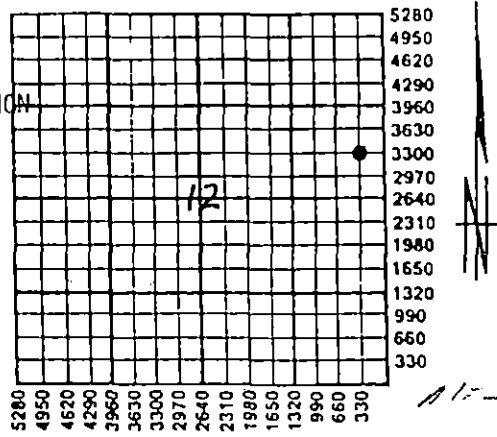


Amount of Surface Pipe Set and Cemented at 263 Feet
Multiple Stage Cementing Collar Used? Yes No
If yes, show depth set _____ Feet
If Alternate II completion, cement circulated from _____
feet depth to _____ w/ _____ sx cmt.

INSTRUCTIONS: This form shall be completed in triplicate and filed with the Kansas Corporation Commission, 200 Colorado Derby Building, Wichita, Kansas 67202, within 120 days of the spud date of any well. Rule 82-3-130, 82-3-107 and 82-3-106 apply. Information on side two of this form will be held confidential for a period of 12 months if requested in writing and submitted with the form. See rule 82-3-107 for confidentiality in excess of 12 months. One copy of all wireline logs and drillers time log shall be attached with this form. ALL CEMENTING TICKETS MUST BE ATTACHED. Submit CP-4 form with all plugged wells. Submit CP-111 form with all temporarily abandoned wells. Any recompletion, workover or conversion of a well requires filing of ACO-2 within 120 days from commencement date of such work.

All requirements of the statutes, rules and regulations promulgated to regulate the oil and gas industry have been fully complied with and the statements herein are complete and correct to the best of my knowledge.

Signature James H. Hess
Title James H. Hess, Vice-President Date 12-15-89
Subscribed and sworn to before me this 29th day of December,
19 89.
Notary Public Bryan K. Hess
Date Commission Expires _____

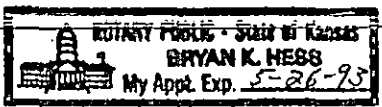

K.C.C. OFFICE USE ONLY
F Letter of Confidentiality Attached
 Wireline Log Received
C Drillers TimeLog Received
Distribution
 KCC SWD/Rep NGPA
 KGS Plug Other
(Specify)