

STATE OF KANSAS
STATE CORPORATION COMMISSION

Form CP-4

Give All Information Completely
Make Required Affidavit
Mail or Deliver Report to:
Conservation Division
State Corporation Commission
212 No. Market
Wichita, Kansas

WELL PLUGGING RECORD

Kiowa County, Sec. 6 Twp. 28 Rge. 16 (E) W (W)

Location as "NE/CNW/SW" or footage from lines G SE NE

Lease Owner Koch Exploration Co.

Lease Name Woodard Well No. #3

Office Address P. O. Box 2256 Wichita, Kansas

Character of Well (completed as Oil, Gas or Dry Hole)

Date well completed 19

Application for plugging filed November 19 69

Application for plugging approved November 19 69


Plugging commenced December 2 19 69

Plugging completed December 8 19 69

Reason for abandonment of well or producing formation

If a producing well is abandoned, date of last production 19

Was permission obtained from the Conservation Division or its agents before plugging was commenced? Yes

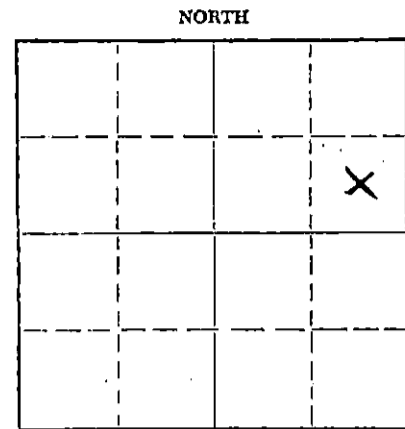

Locate well correctly on above Section Plat

Name of Conservation Agent who supervised plugging of this well Ralph Warren

Producing formation Depth to top Bottom Total Depth of Well Feet

Show depth and thickness of all water, oil and gas formations.

OIL, GAS OR WATER RECORDS

CASING RECORD

FORMATION	CONTENT	FROM	TO	SIZE	PUT IN	PULLED OUT
				8 5/8	280	None
				4 1/2	4774	3015

Describe in detail the manner in which the well was plugged, indicating where the mud fluid was placed and the method or methods used in introducing it into the hole. If cement or other plugs were used, state the character of same and depth placed, from feet to feet for each plug set.

December 2, 1969 Dumped sand to 4650'. Mixed and dumped 4 sx of cement to 4600'

December 8, 1969 Set 20' rock bridge from 260' to 240'. Mixed and dumped 25 sx of cement from 240' to 165'. Filled casing with mud from 165' to 40'. Set 10' rock bridge from 40' to 30'. Mixed and dumped 10 sx of cement from 30' to base of cellar.

RECEIVED
STATE CORPORATION COMMISSION
JAN 14 1970
CONSERVATION DIVISION
Wichita, Kansas

(If additional description is necessary, use BACK of this sheet)

Name of Plugging Contractor RUSS CASING PULLING, INC.

Address P. O. Box 1082 Great Bend, Kansas 67530

STATE OF KANSAS, COUNTY OF SEDGWICK, ss. B. Robison

(employee of owner) or (owner or operator) of the above-described well, being first duly sworn on oath, says: That I have knowledge of the facts, statements, and matters herein contained and the log of the above-described well as filed and that the same are true and correct. So help me God.

(Signature) B. Robison

Box 2256, Wichita, Kansas 67201

(Address)

Subscribed and sworn to before me this 13th day of January, 19 70

Martha J. Charles Notary Public

My commission expires Nov. 8, 1972

