


WELL PLUGGING RECORD

Give All Information Completely
Make Required Affidavit
Mail or Deliver Report to:
Conservation Division
State Corporation Commission
805 Bitting Building
Wichita, Kansas

NORTH

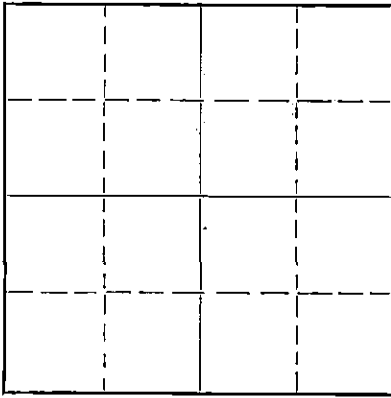

Locate well correctly on above
Section Plat

STAFFORD County. Sec. 27 Twp. 22 Rge. (E) 12 (W)
Location as "NE/CNW $\frac{1}{4}$ SW $\frac{1}{4}$ " or footage from lines NE NE NE
Lease Owner E. H. Adair
Lease Name Scheib Well No. 1
Office Address 407 W-K-H Building, Wichita 2, Kansas
Character of Well (completed as Oil, Gas or Dry Hole) Dry Hole
Date well completed 10/9 19.50
Application for plugging filed 10/10 19.50
Application for plugging approved 10/10 19.50
Plugging commenced 10/10 19.50
Plugging completed 10/10 19.50
Reason for abandonment of well or producing formation Barren

If a producing well is abandoned, date of last production 19.
Was permission obtained from the Conservation Division or its agents before plugging was commenced? Yes

Name of Conservation Agent who supervised plugging of this well C. D. Stough
Producing formation Depth to top Bottom Total Depth of Well 3703 Feet
Show depth and thickness of all water, oil and gas formations.

OIL, GAS OR WATER RECORDS

CASING RECORD

| Formation | Content | From | To | Size | Put In | Pulled Out |
|---------------------------|---------|------|----|------|--------|------------|
| Copy of well log attached | | | | | | |
| | | | | | | |
| | | | | | | |
| | | | | | | |
| | | | | | | |

Describe in detail the manner in which the well was plugged, indicating where the mud fluid was placed and the method or methods used in introducing it into the hole. If cement or other plugs were used, state the character of same and depth placed, from feet to feet for each plug set.

Placed wooden plug at 278' put 15 sx cement on plug filled hole with mud up to 30' from top, placed wood plug at 30' put 10 sx cement on plug filling hole to top of ground.

RECEIVED
STATE CORPORATION COMMISSION
OCT 27 1950
CONSERVATION DIVISION
Wichita, Kansas

10-27-50

(If additional description is necessary, use BACK of this sheet)

Correspondence regarding this well should be addressed to E. H. Adair Oil Company
Address Wichita 2, Kansas

STATE OF Kansas, COUNTY OF Sedgwick, ss.

E. H. Adair (employee of owner or (owner or operator) of the above-described well, being first duly sworn on oath, says: That I have knowledge of the facts, statements, and matters herein contained and the log of the above-described well as filed and that the same are true and correct. So help me God.

(Signature)

Wichita, Kansas

(Address)

SUBSCRIBED AND SWORN TO before me this 13th day of October, 1950

My commission expires September 15, 1953

23-3278-s 4-50-10M

PLUGGING
FILE SEC-27T-22-R(12)
BOOK PAGE 35 LINE 3

Notary Public.

E. H. ADAIR OIL COMPANY

NE NE NE Sec. 27 T 22S R 12W

SCHEIB No. 1

Stafford County

Comm. 9/28/50 Comp. 10/9/50

Elevation Est 1873 DF
1871 Gr

Total Depth 3703'

278' 8 5/8" s casing 200 s x cement

DA

| | |
|--------------------------|-----------|
| Sand | 0-175 |
| Shels & shale | 175-278 |
| Shale | 278-645 |
| Anhydrite | 645-670 |
| Shale | 670-1225 |
| Shale & shells | 1225-1430 |
| Lime | 1430-1778 |
| Shale & shells | 1778-1865 |
| Lime | 1865-1966 |
| Shale & shells | 1966-1985 |
| Lime | 1985-2090 |
| Shale & shells | 2090-2100 |
| Lime | 2100-2140 |
| Shale & shells | 2140-2160 |
| Lime | 2160-2170 |
| Shale & shells | 2170-2210 |
| Shale & Hard Lime Shells | 2210-2314 |
| Shale & shells | 2314-2380 |
| Shale | 2380-2545 |
| Shale & Shells | 2545-2928 |
| Lime | 2928-3180 |
| Shale | 3180-3291 |
| Lime | 3291-3578 |
| Cherty Conglomerate | 3578-3585 |
| Viola Chert | 3585-3640 |
| Shale | 3640-3698 |
| Lime | 3698-3703 |

Certified Correct

E. H. Adair
E. H. Adair

RECEIVED
STATE DEPARTMENT OF CONSERVATION
OCT 27 1950
CONSERVATION DIVISION
TOPEKA, KANSAS

PLUGGING
LIT SEC 27 T 22 S R 12 W
BOOK PAGE 35 LINE 3