


STATE OF KANSAS
STATE CORPORATION COMMISSION

WELL PLUGGING RECORD

Give All Information Completely.
Make Required Affidavit
Mail or Deliver Report to
Conservation Division
State Corporation Comm.
245 North Water
Wichita, KS 67202

Stafford County. Sec. 27 Twp. 22 Rge. 12W E/W
Location as "NE/CNW $\frac{1}{4}$ SW $\frac{1}{4}$ " or footage from lines
35' NE NE NW SE
Lease Owner Marshel Oil & Gas, Inc. and Sanders Oil Company
Lease Name Krey Well No. 1
Office Address 704 Douglas Bldg 104 S. Broadway Wichita, Ks.
Character of Well (Completed as Oil, Gas or Dry Hole)

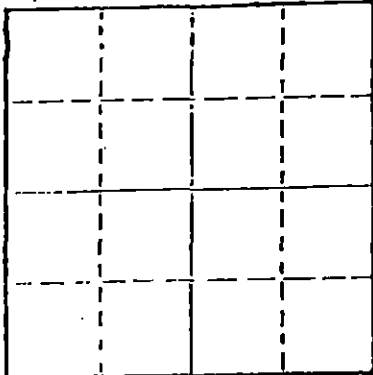

Locate well correctly on above
Section Plot

Date Well completed February 18 1980
Application for plugging filed February 18 1980
Application for plugging approved February 18 1980
Plugging commenced February 18 1980
Plugging completed February 18 1980
Reason for abandonment of well or producing formation

If a producing well is abandoned, date of last production 19

Was permission obtained from the Conservation Division or its agents before plugging was commenced?

Name of Conservation Agent who supervised plugging of this well Wm. T. Owen
Producing formation Depth to top Bottom Total Depth of Well
Show depth and thickness of all water, oil and gas formations.

OIL, GAS OR WATER RECORDS

CASING RECORD

FORMATION	CONTENT	FROM	TO	SIZE	PUT IN	PULLED OUT
				8 5/8	275.25	

Describe in detail the manner in which the well was plugged, indicating where the mud fluid was placed and the method or methods used in introducing it into the hold. If cement or other plugs were used, state the character of same and depth placed, from feet to feet for each plug set.

1st plug 480' with 40 sx.
2nd plug 270' with 35 sx.
3rd plug 40' with 10 sx.

2-26-80

5 sx. in rathole

RECEIVED
FEB 29 1980
CONSERVATION DIVISION
STATE CORPORATION COMMISSION

(If additional description is necessary, use BACK of this sheet)

Name of Plugging Contractor Woodman & Iannitti Drilling Co.

STATE OF KANSAS COUNTY OF SEDGWICK, ss.
K. T. Woodman (employee of owner) or (owner or operator)
of the above-described well, being first duly sworn on oath, says: That I have knowledge of the facts, statements, and matters herein contained and the log of the above-described well as filed and that the same are true and correct. So help me God.

(Signature)

1008 Douglas Bldg. 104 So. Broadway
(Address)

SUBSCRIBED AND SWORN TO before me this 22nd day of February, 19 80

Justina Chamberlain
Notary Public.

My commission expires Feb. 11, 1984

K. T. WOODMAN
RES. PHONE 733-0418
OFF. PHONE 265-7650
WICHITA, KANSAS

WOODMAN & IANNITTI DRILLING COMPANY

Rotary Drilling Contractors

1008 DOUGLAS BUILDING
104 S. BROADWAY
WICHITA, KANSAS 67202

February 21, 1980


Company;	Marshel Oil & Gas, Inc. and Sanders Oil Company
Farm;	#1 Krey
Location;	35' NE NE NW SE
Section;	27-22-12W
County;	Stafford
Contractor;	Woodman & Iannitti Drilling Co.
Total Depth;	3679
Comm;	February 11, 1980
Compl;	February 18, 1980
Casing;	8 5/8 @ 275.25 w/ 225 sx
Production;	D & A

Figures Indicate Bottom Of Formation

145	Sand
235	Shale w/sand streaks
244	Sand
275	Shale
385	Red bed
430	Sand
481	Shale
617	Shale
637	Anhydrite
788	Red bed
1320	Shale
1770	Shale
2015	Shale & Lime
2300	Shale
2600	Shale w/lime streaks
2860	Shale & lime
3080	Shale & lime
3230	Lime
3334	Lime
3390	Lime
3430	Lime
3530	Lime
3615	Lime
3672	Arbuckle
3679	Total Depth

I certify the above to be a true and correct copy of the drillers log to the best of my knowledge and belief.

Woodman & Iannitti Drilling Co.

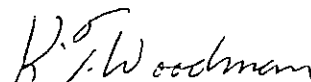

K. T. Woodman

RECEIVED
OIL & NATURAL GAS COMMISSION
FEB 26 1980
CONSERVATION DIVISION
Wichita, Kansas