


Give All Information Completely
Make Required Affidavit
Mail or Deliver Report to:
Conservation Division
State Corporation Commission
212 No. Market
Wichita, Kansas

WELL PLUGGING RECORD

Stafford County, Sec. 27 Twp. 22 Rge. 12 (E) (W) X

Location as "NE/CNW/SW" or footage from lines NW NW SW
Lease Owner Halliburton Oil Producing Company
Lease Name Krankenberg Well No. 1
Office Address 520 Cameron Building Oklahoma City, Oklahoma 73106
Character of Well (completed as Oil, Gas or Dry Hole)
Date well completed 19
Application for plugging filed 19
Application for plugging approved 19
Plugging commenced 7-15-69 19
Plugging completed 7-21-69 19
Reason for abandonment of well or producing formation

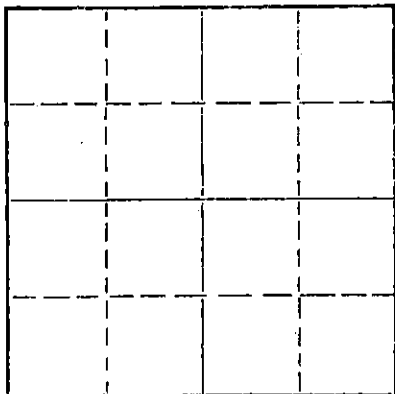

Locate well correctly on above
Section Plat

If a producing well is abandoned, date of last production 19
Was permission obtained from the Conservation Division or its agents before plugging was commenced? Yes

Name of Conservation Agent who supervised plugging of this well Ralph Warren
Producing formation Depth to top Bottom Total Depth of Well 3689 Feet
Show depth and thickness of all water, oil and gas formations.

OIL, GAS OR WATER RECORDS

CASING RECORD

FORMATION	CONTENT	FROM	TO	SIZE	PUT IN	PULLED OUT
				8 5/8	248	None
				5 1/2	None	2657

Describe in detail the manner in which the well was plugged, indicating where the mud fluid was placed and the method or methods used in introducing it into the hole. If cement or other plugs were used, state the character of same and depth placed, from feet to feet for each plug set.

Moved in. Cleaned out cellar. Rigged up unit.
Rigged up jacks. Pushed plug to 3250' with 20' of sand. Dumped 5 sacks of cement. Loaded hole with water. Working pipe.
Shot pipe at 2630'. Working pipe. Pulling pipe.
Pushed plug to 240' rock bridge. Dumped 8 sacks of cement.
Bailed hole dry. Dumped 17 sacks of cement. Mud hole and rock bridge. Capped well with 10 sacks of cement.

RECEIVED
STATE CORPORATION COMMISSION
JUL 28 1969
CONSERVATION DIVISION
Wichita, Kansas

(If additional description is necessary, use BACK of this sheet)
Name of Plugging Contractor Forbes Casing Pulling Company, Inc.
Address P. O. Box 221 Great Bend, Kansas 67530

STATE OF Kansas, COUNTY OF Barton, ss.
James W. Rockhold (employee of owner) or (owner or operator) of the above-described well, being first duly sworn on oath, says: That I have knowledge of the facts, statements, and matters herein contained and the log of the above-described well as filed and that the same are true and correct. So help me God.

(Signature) James W. Rockhold
P. O. Box 221 Great Bend, Kansas
(Address)

SUBSCRIBED AND SWORN to before me this 25 day of July, 19 69

My commission expires May 27, 1973

Notary Public.

STERLING DRILLING COMPANY
Sterling, Kansas

WELL LOG - - - - - KRAMKENBERG #1

Located: NW/4 NW/4 SW/4, Section 27-22S-12W, Stafford County, Kansas

OWNER: Halliburton Oil Producing Company
ROTARY DRILLING CONTRACTOR: Sterling Drilling Company

COMMENCED: 4-3-62
COMPLETED: 4-11-62

ROTARY TOTAL DEPTH: 3687'

LOG

0 - 185 Sand & Gravel
185 - 336 Red Bed
336 - 633 Shale
633 - 657 Anhydrite
657 - 1600 Shale & Shells
1600 - 1770 Lime
1770 - 2360 Shale & Lime
2360 - 2655 Shale
2655 - 2850 Lime & Shale
2850 - 3120 Lime
3120 - 3210 Shale & Lime
3210 - 3275 Shale
3275 - 3461 Lime
3461 - 3590 Lime & Shale
3590 - 3660 Viola
3660 - 3680 Simpson Shale
3680 - 3687 Arbuckle T.D.

CASING RECORD

Set 8 5/8" Surface Casing @
248.80' K.B. with 200 sacks
50 - 50 Pozmix with HA-5.

Ran 5 1/2" Casing @ 3685' with
175 sacks 50 - 50 Pozmix.

RECEIVED
STATE CORPORATION COMMISSION
JUL 9 1969
CONSERVATION DIVISION
Wichita, Kansas