

STATE OF KANSAS
STATE CORPORATION COMMISSION

WELL PLUGGING RECORD
OR
FORMATION PLUGGING RECORD

Strike out upper line
when reporting plug-
ging off formations.

Give All Information Completely
Make Required Affidavit
Mail or Deliver Report to:
Conservation Division
State Corporation Commission,
800 Bitting Building,
Wichita, Kansas

Stafford County. Sec. 23 Twp. 22 Rge. 12 (E) (W)

Location as "NE 1/4 NW 1/4 SW 1/4" or footage from lines

Lease Owner Torey & Feaster Oil Co.

Lease Name Laterman Well No. 1

Office Address Hutchinson, Kans.

Character of Well (Completed as Oil, Gas or Dry Hole)

Date, well completed 19

Application for plugging filed 193

Application for plugging approved 193


Plugging Commenced Jan., 3 1938

Plugging Completed Jan., 11 1938

Reason for abandonment of well or producing formation

If a producing well is abandoned, date of last production 193

Was permission obtained from the Conservation Division or its agents before plugging was commenced? Yes

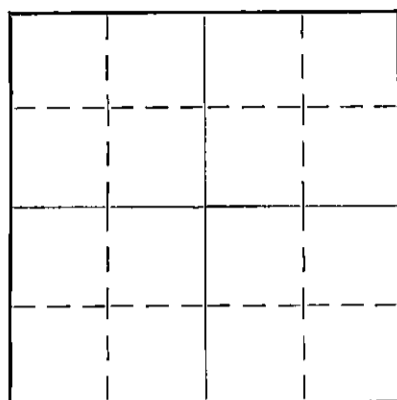

Locate well correctly on above
Section Plat

Name of Conservation Agent who supervised plugging of this well

Producing formation Depth to top Bottom Total Depth of Well 3683 Feet

Show depth and thickness of all water, oil and gas formations.

OIL, GAS OR WATER RECORDS


CASING RECORD

Formation	Content	From	To	Size	Put In	Pulled Out
				7"	3675	1785'
				Cemented	12"	230

Describe in detail the manner in which the well was plugged, indicating where the mud fluid was placed and the method or methods used in introducing it into the hole. If cement or other plugs were used, state the character of same and depth placed, from feet to feet for each plug set.

Bridged hole with rock at 230' with 20' of cement.

Bridged hole 20 ft. from bottom of cellar & filled to bottom of cellar with cement.

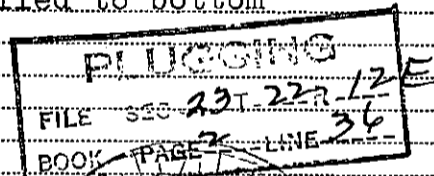

(If additional description is necessary use BACK of this sheet)

Correspondence regarding this well should be addressed to Torey & Feaster Oil Co.

Address Hutchinson, Kans.

STATE OF Kansas, COUNTY OF Stearns, ss.

O. E. Torrey (employee of owner) or (owner or operator) of the above-described well, being first duly sworn on oath, says: That I have knowledge of the facts, statements, and matters herein contained and the log of the above-described well as filed and that the same are true and correct. So help me God.

(Signature) O E Torrey

608 Wolcott Building, Hutchinson, Kansas

(Address)

SUBSCRIBED AND SWORN to before me this 4 day of February, 1938

My commission expires Nov. 4 - 1939

Ruth Pickens
Notary Public.


WELL LOG BUREAU - KANSAS GEOLOGICAL SOCIETY.
412 Union National Bk Bldg, Wichita, Kansas.

TORREY & FEASTER.
Lanternman No. 1

SEC. 23 T. 22 R. 12W.
SW SW NE

Total Depth. 3688
Comm. 11-26-37 Comp. 12-16-37
Shot or Treated.
Contractor.
Issued. 1-8-38

County Stafford.

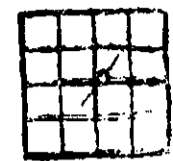

CASING.

13" 170'
7" 3675'

Elevation.

Production. Dry.

Figures Indicate Bottom of Formations.

sand	80	lime	3164
sand and red rock	177	lime and shale	3277
red rock and shells	460	shale	3302
lime and shale	672	K.C. lime	3410
lime and shale	695	small show oil	3410
shale blue & shells	735	K.C. lime hard white	3434
red bed and shells	748	lime soft porous	3437
blue shale & shells	1020	K.C. lime	3535
lime and shale	1135	shale and sdy lime	
shale blue and shells		shells	3544
salt	1376	lime	3551
salt and shells	1420	shale	3559
lime and shale blue	1520	conglomerate	3570
lime and shale	1647	Viola	3575
lime hard	1722	Viola lime	3598
lime and shale	1760	Top 3571	
broken lime soft	1786	Simpson	3648
lime and shale	1815	siliceous lime	3678
shale and shells	1830	show of oil	
lime	1855	saturated	3683
shale and shells	1870	cored from 3683 to 3688	
lime	1935		
lime and shale	1987	Total Depth.	
lime	2030	saturated core.	
shale and shells	2050	hole filled with sulfur water.	
lime	2200		
lime and shale	2253		
soft porous lime	2261		
lime	2350		
lime and shale	2850		
Top of Topeka lime	2840		
lime Topeka	2960		
lime	2985		
soft lime shale	3007		
lime soft	3020		
lime hard	3050		
broken lime	3065		

PLUGGING
FILE SEC 23 T 22 R 12W
BOOK PAGE 2 LINE 36

