

STATE OF KANSAS
STATE CORPORATION COMMISSION


WELL PLUGGING RECORD

Give All Information Completely
Make Required Affidavit
Mail or Deliver Report to:
Conservation Division
State Corporation Commission
800 Bittling Building
Wichita, Kansas

OR
FORMATION PLUGGING RECORD

Strike out upper line
when reporting plugging
of formations.

Stafford County. Sec. 23 Twp. 22 Rge. ~~12~~ 12 (W)
Location as "NE 1/4 NW 1/4 SW 1/4" or footage from lines. NW 1/4 NE 1/4 SW 1/4
Lease Owner G. W. Keyes Drilling Company
Lease Name Lanterman Well No. 1
Office Address Ellinwood, Kansas
Character of Well (completed as Oil, Gas or Dry Hole) Dry Hole
Date well completed January 31 19 49
Application for plugging filed January 31 19 49
Application for plugging approved January 31 19 49
Plugging commenced January 31 19 49
Plugging completed January 31 19 49
Reason for abandonment of well or producing formation Dry Hole
If a producing well is abandoned, date of last production None 19
Was permission obtained from the Conservation Division or its agents before plugging was commenced? Yes

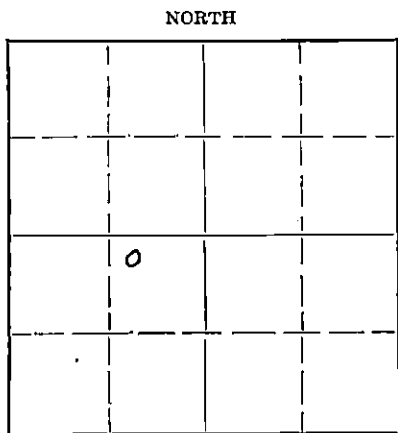

Locate well correctly on above
Section Plat

Name of Conservation Agent who supervised plugging of this well C. D. Stough
Producing formation None Depth to top Bottom Total Depth of Well 3702 Feet
Show depth and thickness of all water, oil and gas formations.

OIL, GAS OR WATER RECORDS

CASING RECORD

Formation	Content	From	To	Size	Put In	Pulled Out
Surface Pipe		0'	279'	8-5/8	279'	None

Describe in detail the manner in which the well was plugged, indicating where the mud fluid was placed and the method or methods used in introducing it into the hole. If cement or other plugs were used, state the character of same and depth placed, from _____ feet to _____ feet for each plug set.

Mudded hole from 3702' to 270'. Set rock bridge at 270' and cemented with 20 sacks cement. Mudded hole to within 40' of top. Set rock bridge at 40' and cemented with ten sacks, cement returning to surface.

RECEIVED
Conservation Div.
FEB 15 1949
STATE CORPORATION COMMISSION
WICHITA

2-15-49

(If additional description is necessary, use BACK of this sheet)

Correspondence regarding this well should be addressed to Keyes Drilling Company
Address Ellinwood, Kansas

STATE OF Kansas, COUNTY OF Barton, ss.
I, Edw. H. Isern, Part Owner (employee or owner or owner or operator) of the above-described well, being first duly sworn on oath, says: That I have knowledge of the facts, statements, and matters herein contained and the log of the above-described well as filed and that the same are true and correct. So help me God.

(Signature) *Edw. H. Isern*
Ellinwood, Kansas
(Address)

SUBSCRIBED AND SWORN to before me this 5th day of February, 19 49.
George A. Meyer
Notary Public.

My commission expires February 10, 1951

22-2626 2-18-15M
PLUGGING
FILE SEC 23 T 22 R 12
BOOK PAGE 81 LINE 88

WELL LOG

G. W. KEYES DRILLING COMPANY, et al, OWNERS - Lanterman #1
 NW NE SW Section 23; Township 22, Range 12 W
 Stafford County, Kansas

		Figures Indicate Bottom of Formation:	
		0	to 30
Elevation:	1868 DF		sand
Pipe Record:			180 shale & sand
8-5/8" set at 279'			190 red shale
			250 sand, clay & shells
			279 red bed
			650 red bed, shale & shells
Tops corrected 3' to derrick floor			690 anhydrite
		1080	shale & shells
Heebner shale	3166	1290	shale & salt
Base Oread	3196	1460	shale & shells
Brown Lime	3298	1550	shale & lime
Lansing Lime	3316	1720	Lime & shale
Shale Conglomerate	3574	1775	lime
Viola Chert	3584	2255	lime & shale
Simpson Shale	3634	2330	shale & lime
Simpson Sand	3693	2410	lime & shale
Arbuckle Dol.	3696	2640	shale & shells
		2805	lime & shale
		2865	shale & lime
		2890	lime
		3165	lime & shale
Rotary Commenced	1-16-49	3375	shale & lime
Completed	1-31-49	3525	lime
		3590	lime & shale
		3636	chert
		3695	shale
		3698	sand
		3702	arbuckle lime
		3702	Total Depth D & A

RECEIVED

Conservation Div.

FEB 15 1949

STATE CORPORATION
 COMMISSION
 KANSAS

STATE OF KANSAS)
 COUNTY OF BARTON) SS

I, Edw. H. Isern, Part Owner of the above-described well, being first duly sworn on oath, declare: That I have knowledge of the facts, statements and matters herein contained pertaining to the log of the above-described well, as filed, and that the same are true and correct.

Edw. H. Isern

Subscribed and Sworn to before me this 8th day of February, 1949.

PLUGGING
 FILE SEC 23-T 24-R 170
 BOOK PAGE 8/LINE 28

George A Meyer
 Notary Public

My commission expires Feb. 10, 1951